


KANSAS

Section 16 Township 17 Range 11W

Well No. 4 Gibler

Company Shell Oil Co.

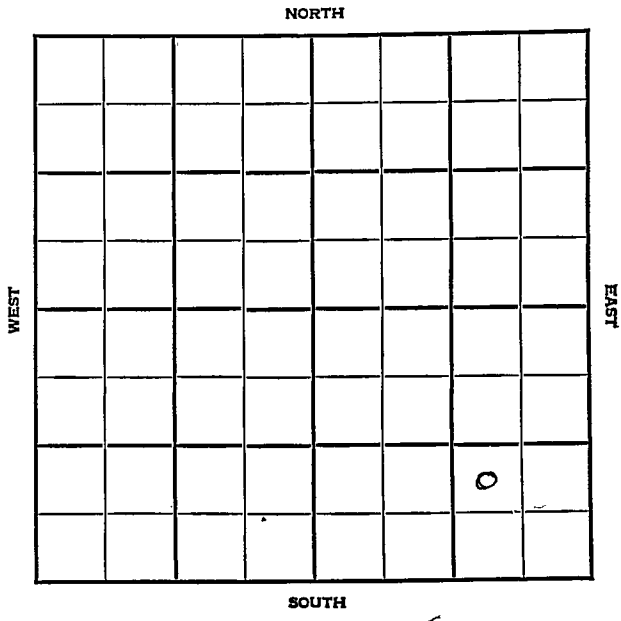

Sec. 16 Twp. 17 R. 11W

Well No. #4 Gibler Farm

Shell Company


Kraft-Prusa

 Ft. from N. Line

990 Ft. from S. Line

990 Ft. from E. Line

 Ft. from W. Line

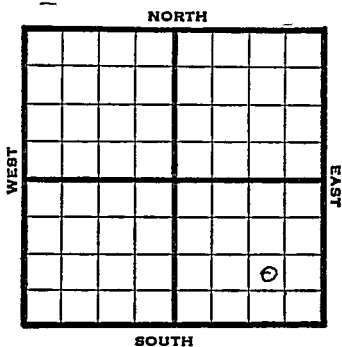

NW SE SE

1948 Elev. 1809' REPORT

- 4/28 8" @ 345'
- 5/5 Topeka 2610'
Drlg. 3102'
- 5/12 Lansing 2979'
Arbuckle 3245'
TD 3247'
4 1/2" @ 3246'
RUST
- 5/19 TD 3257'
1000 Acid swb 7 bbls oil PH 2 hrs.
- 5/26 TD 3261'
500 Acid
Swb 37 bbls oil PH 5 hrs.
- 6/1 "
- 6/9 Arb. 3245'
4 1/2" @ 3246'
500 acid
Echo Pot 1066 oil / 44 W P
42.0 Gr.
TD 3261'
Comp.

COMPLETED

Map No. _____ Sec. 16 Twp. 17 R. 11W

Well No. 4 Gibler

Shell _____ Company

FIRST REPORT _____ Contractor

NW SE SE

SECTION PLAT

_____ Ft. from N. Line

990 Ft. from S. Line

990 Ft. from E. Line

_____ Ft. from W. Line

			o

Barton County

Location _____

Rig up _____

Drilling and Remarks:

8" @ 345

RECORD

Cased _____ in., _____ ft.

Sand _____

Gas _____

Oil _____

Total Depth _____

PRODUCTION

1st 24 hrs. Nat. _____

1st 24 hrs. after shot _____

Gas _____ Cu. Ft.

Dry Hole _____

Abandoned _____

Date

APR 28 1948 19

S. J. LEWIS Scout

