
DX 78-1

Barton KANSAS

Section 16 Township 17 Range 11W

Well No. 2 Barth

Company Aledo Oil

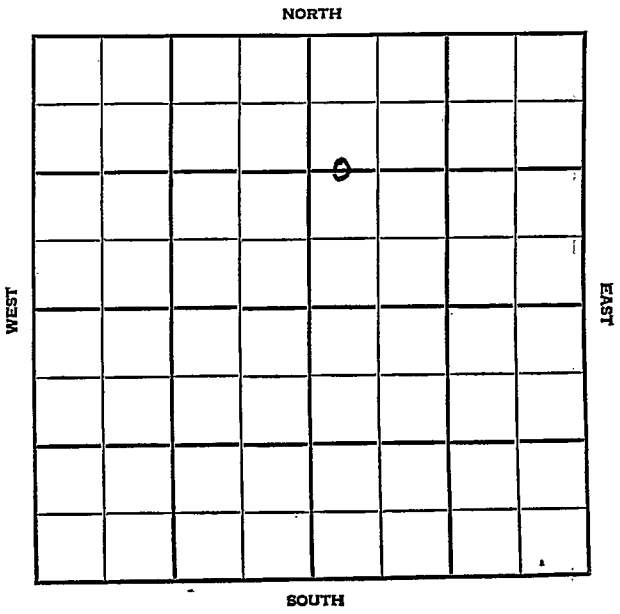

Barton KANSAS

SEC.	TWP.	R.
16	17	11W

WELL NO.

#2 Barth FARM

COMPANY

Aledo Oil

CONTRACTOR

Kraft-Prusa


1320 Ft. from N. Line

Ft. from S. Line

Ft. from E. Line

330 Ft. from W. Line

C W½ W½ NE

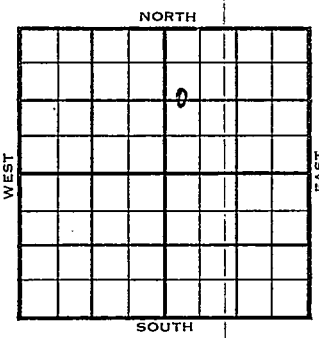

1955 ELEVATION 1841 REPORT

1/12 Location

4/6 Spud 2-25-55, oil well, TD 3310 8" @ 220; Anhy 690, Heeb 2902, Tor 2920, Br. Lime 3003, Lans 3017, DST 3105-15, open ½ hr. Rec. 30' G & WCM, 1010#, Arb 3290, TD 3295, 5" @ 3292, DD 3300, 1 BOPH, 500 A BD 3310, S/3½ BOPH 3 hr.
Comp. 89 BOPD

COMPLETED

DX-78

FORM 275 FOR SALE BY KANSAS BLUE PRINT CO.

County Barton State Kansas

Sec. 16 (Blk. Twp.) 17 (Sur. Rge.) 11W Map No.

Operator Aledo Oil

Well No. 2 Farm Barth

Elev. 1841 Location C W½ W½ NE



1320 Ft. From N Line NE

330 Ft. From W Line Quarter

1st. Report JAN 1 2 1955

Completion

Remarks

Spudding Date

Drlg. Data Kraft-Prusa Pool

Location

FABEN GULSTAD

FORM 275 FOR SALE BY KANSAS BLUE PRINT CO.


County Barton State Kansas

Sec. 16 (Blk. Twp.) 17 (Sur. Rge.) 11W Map No.

Operator Aledo Oil

Well No. 2 Farm Barth

Elev. 1841 Location C W½ W½ NE

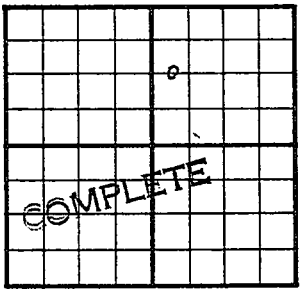

1320 Ft. From N Line NE

330 Ft. From W Line Quarter

1st. Report

Completion APR 6 1955

Remarks Kraft-Prusa Pool

Stearns - Contr.

Spudding Date 2-25-55

Drlg. Data Oil well TD 3310

8" @ 220 Anhy 690 Heeb. 2902

Tor. 2920 Br. lime 3003 Lans. 3017

DST 3105-15 open ½ hr. Rec. 30' g & wcm

1010# Arb. 3290 TD 3295 5" @ 3292

DD 3300 1 boph 500' A DD 3310

S/ 3½ boph 3 hr. Comp. 89 bopd

FABEN GILSTRAP