

# KANSAS


Barton

FORM 51 5M 10-41 PETROL

Section 16 Township 17 Range 11-W

Well No. #2 Gibler

Company Shell

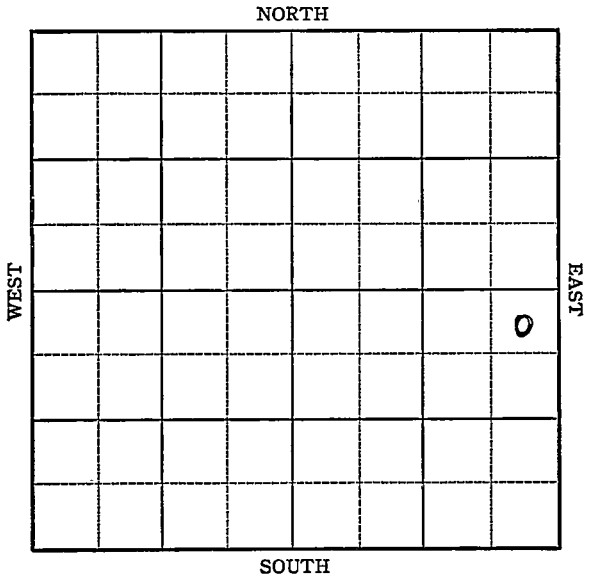

Sec. 16 Twp. 17 R. 11-W

Well No. #2 Gibler Farm \_\_\_\_\_

Shell Company \_\_\_\_\_


(Kraft Prusa)

330 Ft. from N. Line

\_\_\_\_\_ Ft. from S. Line

330 Ft. from E. Line

\_\_\_\_\_ Ft. from W. Line

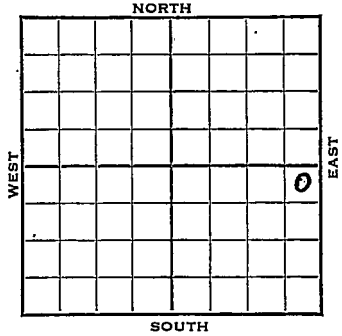

1942

REPORT

7/15 8" - 351'  
Drlg. 1150'

7/22 Drlg. 2890'

7/29 Lans. 3020.  
Arv. 3288-91 T.D.

4" - 3289 RUST

8/5 T.D. 3296 Swab water S.D.

8/12 Arb. 3288  
T.D. 3296  
4" - 3289  
Water.

ABANDONED

**Barton KANSAS**

Map No. 55 Sec. 16 Twp. 17 R. 11W

Well No. 2 Gibler

Shell

Company

**FIRST REPORT**

Contractor

**NE SE**

**SECTION PLAT**

330 Ft. from N. Line

\_\_\_\_\_ Ft. from S. Line

330 Ft. from E. Line

\_\_\_\_\_ Ft. from W. Line

			8

**KRAFT PRUSA POOL**

Location \_\_\_\_\_

Rig up \_\_\_\_\_

Drilling and Remarks:

**8" - 351'**

**Dr1g. 1150'**

**RECORD**

Cased \_\_\_\_\_ in., \_\_\_\_\_ ft.

Sand \_\_\_\_\_

Gas \_\_\_\_\_

Oil \_\_\_\_\_

Total Depth \_\_\_\_\_

**PRODUCTION**

1st 24 hrs. Nat. \_\_\_\_\_

1st 24 hrs. after shot \_\_\_\_\_

Gas \_\_\_\_\_ Cu. Ft.

Dry Hole \_\_\_\_\_

Abandoned \_\_\_\_\_

Date

JUL 15 1942 19

S. J. LEWIS Scout

Map No. 55 Sec. 16 Twp. 17 R. 11W

Well No. 2 Gibler

Shell

Company

ABANDONED

Contractor

NE SE

SECTION PLAT

330 Ft. from N. Line

\_\_\_\_\_ Ft. from S. Line

330 Ft. from E. Line

\_\_\_\_\_ Ft. from W. Line

			o

KRAFT PRUSA POOL

Location \_\_\_\_\_

RECORD

Cased \_\_\_\_\_ in., \_\_\_\_\_ ft.

Rig up \_\_\_\_\_

Sand \_\_\_\_\_

Drilling and Remarks:

Gas \_\_\_\_\_

*Cr #3288*

Oil \_\_\_\_\_

*4" @ 3289*

Total Depth 3296

*Water*

PRODUCTION

1st 24 hrs. Nat. \_\_\_\_\_

1st 24 hrs. after shot \_\_\_\_\_

Gas \_\_\_\_\_ Cu. Ft.

Dry Hole \_\_\_\_\_

Abandoned \_\_\_\_\_

Date

AUG 12 1942

S. J. LEWIS Scout