FORM 51 10M 8-47


KANSAS

Barton

Section 16 Township 17 Range 11W

Well No. #2 Hertel

Company Dale Ives

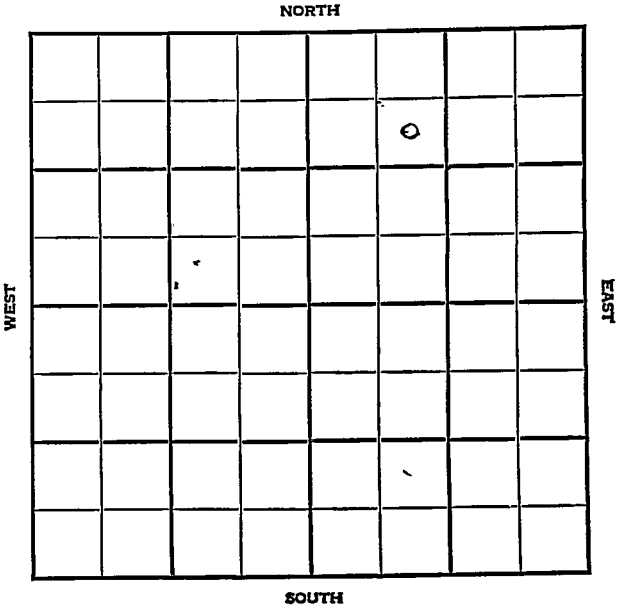

FORM 252-A
5M 9-47 PETROL

KANSAS Barton ✓

Sec. 16 Twp. 17 R. 11W

Well No. #2 Hertel. Farm

Dale Ives Company

Kraft-Prusa Pool


990' Ft. from N. Line

_____ Ft. from S. Line

_____ Ft. from E. Line

990' Ft. from W. Line

SE NW NE

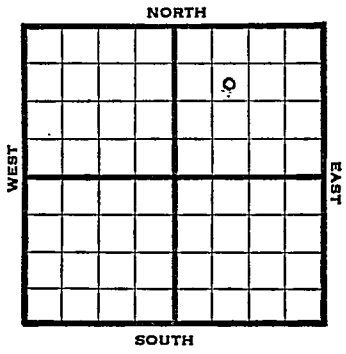

1948	Elev. 1843' REPORT
2/4	Surface Hole
2/11	8" @ 221' Drlg. 2825'
2/18	"
2/25	Lans. 3030' Cong. 3313' TD 3320' Abd.

ABANDONED

Form 26 200 Bks. 10-46 Petrol

Kraft-Prusa Pool

Kansas

Map No. ____ Sec. 16 Twp. 17 R. 11W

Well No. 2 Hertel

Dale Ives Company

FIRST REPORT Contractor

SE NW NE


990 Ft. from N. Line

____ Ft. from S. Line

____ Ft. from E. Line

990 Ft. from W. Line

SECTION PLAT

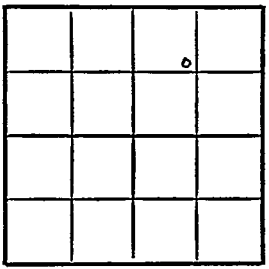

Barton County

Location ____

Rig up ____

Drilling and Remarks:

surface hole

RECORD

Cased ____ in., ____ ft.

Sand ____

Gas ____

Oil ____

Total Depth ____

PRODUCTION

1st 24 hrs. Nat. ____

1st 24 hrs. after shot ____

Gas ____ Cu. Ft.

Dry Hole ____

Abandoned ____

Date

FEB 4 1948 19 S. J. LEWIS Scout

Form 26—200 Bks.—1-48—Palace

Kraft-Prusa Pool

Kansas

Map No. 55 Sec. 16 Twp. 17 R. 11W

Well No. 2 Hertel


Dale Ives Company

ABANDONED Contractor

SE NW NE

E. 1/2 NE

SECTION PLAT

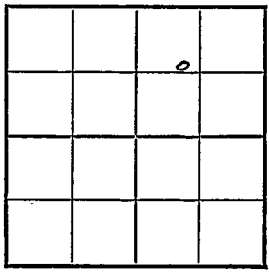

990 Ft. from N. Line

Ft. from S. Line

Ft. from E. Line

990 Ft. from W. Line

Barton County

Location

Rig up

Drilling and Remarks:

Lans 3030
Conq 3318

RECORD

Cased in., ft.

Sand

Gas

Oil

Total Depth 3320

PRODUCTION

1st 24 hrs. Nat.

1st 24 hrs. after shot

Gas Cu. Ft.

Dry Hole

Abandoned

Date

FEB 25 1948 19

S. J. LEWIS Scout