


Section 16 Township 17 Range 11-W

Well No. #2 Lamatch

Company Stanolind

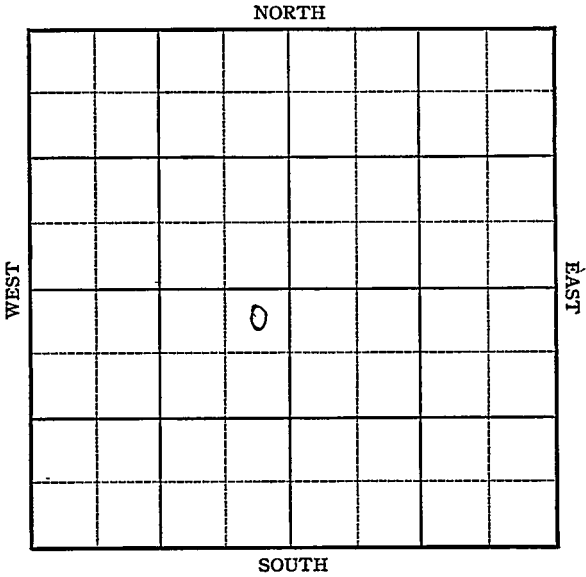

# KANSAS

Barton

Sec. 16 Twp. 17 R. 11-W

Well No. #2 Lamatch Farm

Stanolind Company

Kraft Prusa


330 Ft. from N. Line

\_\_\_\_\_ Ft. from S. Line

330 Ft. from E. Line

\_\_\_\_\_ Ft. from W. Line

*elw, 1840*

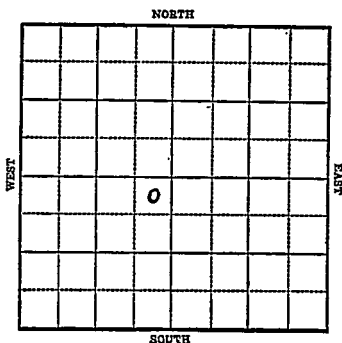

1943

## REPORT

5/22 8" @ 356'  
Waiting on cement

5/19 Anhy 690  
Drlg. 2525

5/26 Lans 3028  
Drlg. 3295'

6/2 Arb. 3306  
5" @ 3305'  
T.D. 3310'  
300 gal acid  
Water

**ABANDONED**

Barton

KANSAS

Map No. 55 Sec. 16 Twp. 17 R. 11WWell No. 2 LamatchStanolind

Company

FIRST REPORT

Contractor

NE SW

## SECTION PLAT

330 Ft. from N. Line

\_\_\_\_\_ Ft. from S. Line

330 Ft. from E. Line

\_\_\_\_\_ Ft. from W. Line

		o	

KRAFT PRUSA POOL

Location \_\_\_\_\_

Rig up \_\_\_\_\_

Drilling and Remarks:

8" - 356'

Waiting on  
cement

## RECORD

Cased \_\_\_\_\_ in., \_\_\_\_\_ ft.

Sand \_\_\_\_\_

Gas \_\_\_\_\_

Oil \_\_\_\_\_

Total Depth \_\_\_\_\_

## PRODUCTION

1st 24 hrs. Nat. \_\_\_\_\_

1st 24 hrs. after shot \_\_\_\_\_

Gas \_\_\_\_\_ Cu. Ft.

Dry Hole \_\_\_\_\_

Abandoned \_\_\_\_\_

Date

MAY 12 1943

19

S. L. LEWIS Scout

**KANSAS**

Barton

Map No. 55 Sec. 16 Twp. 17 R. 11W

Well No. 2 Lamatch

Stanolind Company

**ABANDONED** Contractor

NE SW

SECTION PLAT

330 Ft. from N. Line

\_\_\_\_\_ Ft. from S. Line

330 Ft. from E. Line

\_\_\_\_\_ Ft. from W. Line

	o		

**KRAFT PRUSA POOL**

Location \_\_\_\_\_

Rig up \_\_\_\_\_

Drilling and Remarks:

*Cor 83306  
5" 83305  
300 and  
Water*

**RECORD**

Cased \_\_\_\_\_ in., \_\_\_\_\_ ft.

Sand \_\_\_\_\_

Gas \_\_\_\_\_

Oil \_\_\_\_\_

Total Depth 3310

**PRODUCTION**

1st 24 hrs. Nat. \_\_\_\_\_

1st 24 hrs. after shot \_\_\_\_\_

Gas \_\_\_\_\_ Cu. Ft.

Dry Hole \_\_\_\_\_

Abandoned \_\_\_\_\_

Date

JUN 2 1943 19

S. J. LEWIS Scout