DX 78-1


Barton

KANSAS

Section 16 Township 17 Range 11W

Well No. #3 Barth

Company Aldeo Oil Co.

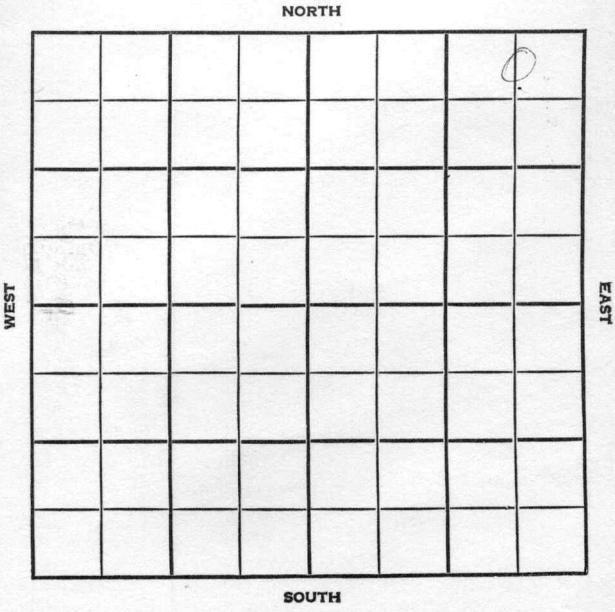

FORM 513 SUNRAY

County Barton Elev.

Sec. 16 Twp. 17 Rge. 11W

Company Aldeo Oil Co.

Farm Name Barth No. 3

TOPS	DEPTH	LOG	DATUM
Anh.			
Tp.			
H.			
Tr.			
Dg.			
Bl.			
L.			
K.C.			
B.K.C.			
Ce.			
C.			
M.			
M.			
K.			
Mz.			
Mo.			
V.			
S.			
S.			
A			
R.			
P€.			
G.			
T.D.			

Loc. in Sec.
N/2 NE NE

Geol.

Contr.
Smitherman Tool

Pool
Kraft-Prusa

NOV 14 '56

FIRST REPORT

Date Comm. 11-8-56

8" @ 298 w/ cmt. Drlg. 2529

Co. Lse. No. Sec. T. R.

FORM 513 SUNRAY

County Barton Elev. 1833

Sec. 16 Twp. 17 Rge. 11W

Company Aledo Oil Co.

Farm Name Barth No. 3

TOPS	DEPTH	LOG	DATUM
Anh.			
Tp.			
H.	2881		
Tr.			
Dg.			
Bl.	2983		
L.			
K.C.	2999		
B.K.C.			
Ce.			
C.			
M.			
M.			
K.			
Mz.			
Mo.			
V.			
S.			
S.			
A rework	3267		
R. Ark	3285		
P€.			
G.			
T.D.	3295		

Loc. in Sec. N/2 NE NE

Geol.

Contr. Smitherman Tool

Pool Kraft-Prusa

JAN 30 57

COMPLETE

Date Comm. 11-8-56

8" @ 298 w/ cmt. Drlg. 2529 NOV 21 '56 Pipe set NOV 28 '56 5½ @ 3285 co 3295 Tite Pop DEC 5 '56 DEC 12 '56 ✓ DEC 19 '56 ✓ DEC 26 '56 ✓ JAN 2 '57 ✓ JAN 9 '57 ✓ JAN 16 '57 JAN 23 '57 ✓ JAN 30 '57

DST 3270-95 1hr rec 80' clean oil + 430' Mdy oil BHP 1015/20" co 3295 50 gal acid Pat. P. 40

~~BH~~ Bopd no/wtr.

Co. Lease No. Sec. T. R.