

Barton


KANSAS

SECTION 16 TOWNSHIP 17S RANGE 11W

WELL NO. #4 Barth

COMPANY Sierra Petroleum

NORTH N/2 N/2 NE

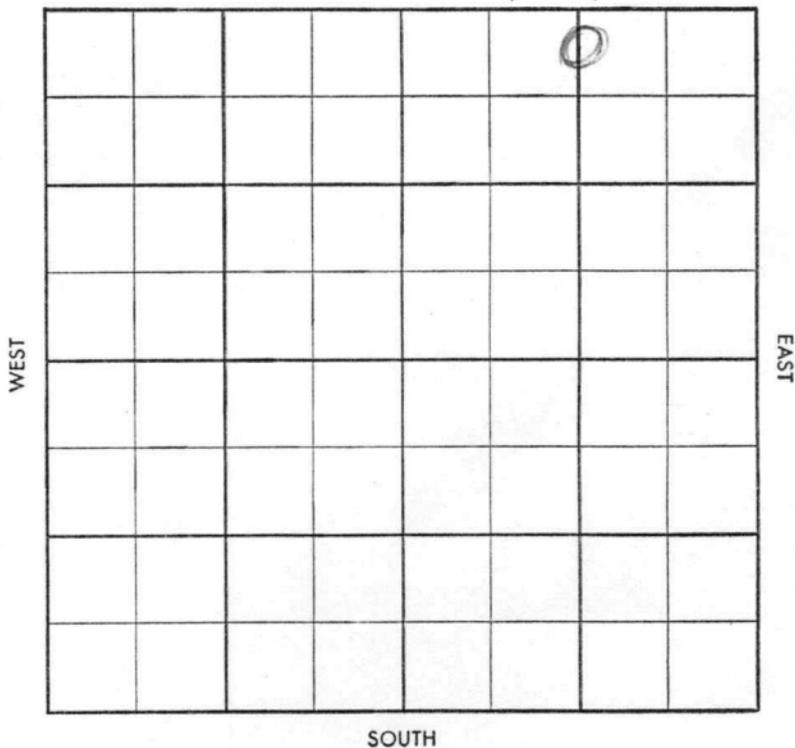

~~Kraft Prusa~~

County Barton Elev. _____
 Sec. 16 Twp. 17 Rge. 11W
 Company Sierra Petroleum
 Farm Name Barth No. 4

TOPS	DEPTH	LOG	DATUM
Anh.			
Tp.			
H.			
Tr.			
Dg.			
B.L.			
L.			
K.C.			
B.K.C.			
Ce.			
C.			
M.			
M.			
K.			
Mz.			
Mq.			
V.			
S.			
S.			
A.			
R.			
Pf.			
G.			
T.D.			

Loc. in Sec. _____
N/2 N/2 NE
 Geol. _____
 Contr. _____
Co. Tools #9
 Pool _____
Kraft-Prusa



Date Comm. 3/10/58
 Drlg. 160, to set 8" @ 300.

Co.
Lse.
No.
Sec.
T.
R.

Twp. X Pool Kraft-Prusa

Co. X Facet X

S-513.B

County Barton Elev. 184301 1842 110
 Sec. 16 Twp. 17 Rge. 11W
 Company Sierra Petroleum
 Farm Name Barth No. 4

TOPS	DEPTH	LOG	DATUM
Anh.	<u>691</u>		
Tp.			
H.	<u>2895</u>		
Tr.			
Dg.			
B.L.	<u>2998</u>		
L.	<u>3014</u>		
K.C.			
B.K.C.			
Ce.			
C.	<u>3274</u>		
M.			
M.			
K.			
Mz.			
Mq.			
V.			
S.			
S.			
A.			
R.			
Pf.			
G.			
T.D.	<u>3320</u>		

Loc. in Sec. N/2 N/2 NE
 Geol. _____
 Contr. _____
 Co. Tools # 9
 Pool _____
Kraft-Prusa

ABANDONED
 MAR 27 1958

Date Comm. 3/10/58
 Drlg. 160, to set 8" @ 300. MAR 19 58 2 3180

MAR 26 58 no log at DSR

DSR