

KANSAS

WELL COMPLETION REPORT AND  
DRILLER'S LOG

*State Geological Survey*  
WICHITA BRANCH

S. 5 T. 28 R. 17 E  
W

Loc. NE 1/4

County Wilson

API No. 15 — 205 — 22,378  
County Number

Operator  
Gulf Coast Royalty Co.

Address  
1900 West Loop South, Suite 1900, Houston, Tx.


Well No. # 62 Lease Name Carlson

Footage Location  
250' feet from (N) (S) line 225' feet from (E) (W) line

Principal Contractor L-K Drilling Geologist Chris Seay

Spud Date 11-4-81 Date Completed 11-7-81 Total Depth 840' P.B.T.D. None

Directional Deviation none Oil and/or Gas Purchaser gas Cities Service

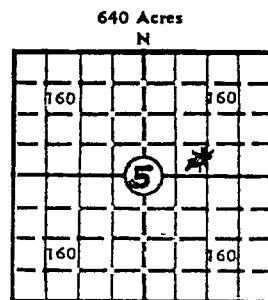

Elev.: Gr. 979  
DF \_\_\_\_\_ KB \_\_\_\_\_

CASING RECORD

Report of all strings set — surface, intermediate, production, etc.

Purpose of string	Size hole drilled	Size casing set (in O.D.)	Weight lbs/ft.	Setting depth	Type cement	Sacks	Type and percent additives
Surface	8 3/4"	7"	24	60'	Portland A	10	
Production	6 1/2"	4 1/2"	9.5	800	Portland A	90	2 % gel

LINER RECORD None

PERFORATION RECORD None

Top, ft.	Bottom, ft.	Sacks cement	Shots per ft.	Size & type	Depth interval

TUBING RECORD none

OPEN HOLE COMPLETION

Size	Setting depth	Packer set at

ACID, FRACTURE, SHOT, CEMENT SQUEEZE RECORD

Amount and kind of material used	Depth interval treated
None	

INITIAL PRODUCTION

Date of first production SI Producing method (flowing, pumping, gas lift, etc.) flowing

RATE OF PRODUCTION PER 24 HOURS Oil Gas Water Gas-oil ratio  
bbis. 193,000 MCF none bbis. dry gas CFPB

Disposition of gas (vented, used on lease or sold) sold Producing interval (s) 820'-840'

INSTRUCTIONS: As provided in KCC Rule 82-2-125, within 90 days after completion of a well, one completed copy of this Drillers Log shall be transmitted to the State Geological Survey of Kansas, 4150 Monroe Street, Wichita, Kansas 67209. Copies of this form are available from the Conservation Division, State Corporation Commission, 245 No. Water, Wichita, Kansas 67202. Phone AC 316-522-2206. If confidential custody is desired, please note Rule 82-2-125. Drillers Logs will be an open file in the Oil and Gas Division, State Geological Survey of Kansas, Lawrence, Kansas 66044.

Operator Gulf Coast Royalty Co.		DESIGNATE TYPE OF COMP.: OIL, GAS, DRY HOLE, SWDW, ETC.:
Well No. #5	Lease Name Carlson	Gas
S 5 T 28 R 17 E		

**WELL LOG**

Show all important zones of porosity and contents thereof; cored intervals, and all drill-stem tests, including depth interval tested, cushion used, time tool open, flowing and shut-in pressures, and recoveries.

-SHOW GEOLOGICAL MARKERS, LOGS RUN, OR OTHER DESCRIPTIVE INFORMATION.

FORMATION DESCRIPTION, CONTENTS, ETC.	TOP	BOTTOM	NAME	DEPTH
** SEE ATTACHED WELL LOG SHEET				

USE ADDITIONAL SHEETS, IF NECESSARY, TO COMPLETE WELL RECORD.

Date Received	<i>Cherry E. Holder</i>
	Cherry E. Holder <small>Signature</small>
	Gulf Coast Royalty Co. - Secretary
	<small>Title</small>
	<i>7/4/82</i>
	<small>Date</small>

