


Section 16 Township 17 Range 11W

Well No. 5 Grossardt,


Company Lauck & Moncrief

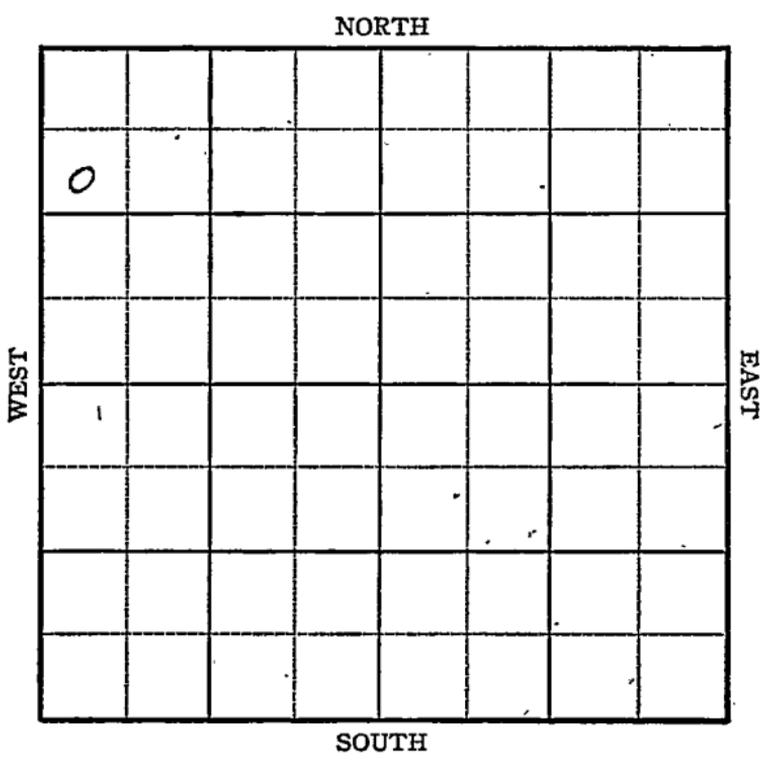

Sec. 16 Twp. 17 R. 11-W

Well No. #5 Grossardt Farm
Lauck & Moncrief Company

990 Ft. from N. Line
____ Ft. from S. Line
____ Ft. from E. Line
330 Ft. from W. Line

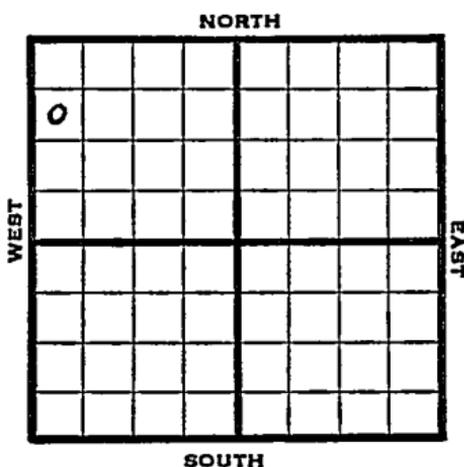

SW NW NW Elev. 1840

1945

REPORT

9/12	RUR			
9/19	10" @ 197			
	Drig. 2025			
9/26	Arb. 3288			
	TD 3291'			
	5" @ 3288 RUST			
10/3	Arb. 3286 corrected			
	5" @ 3287			
	TD 3300			
	Swb. 15 oil 1 hr.			
10/10	" " " "			
10/17	" " " "			
10/24	" " " "			
10/31	" " " "			
11/7	" " " "			
11/14	" " " "			
11/21	" " " "			
11/28	" " " "			
12/5	" " " "			
12/12	Arb. 3286			
	5" @ 3287			
	TD 3300'			
	Pump 173 Pot.			
	Grav. 42.0			

COMPLETED

Kraft-Prusa

KANSAS

Pool Name

Map No. 55 Sec. 16 Twp. 17 R. 11WWell No. 5 Grossardt

Lauck & Moncrief

Company

FIRST REPORT

Contractor

SW NW NW

SECTION PLAT

990 Ft. from N. Line Ft. from S. Line Ft. from E. Line330 Ft. from W. Line

o			

Barton County

Location Rig up

Drilling and Remarks:

R U R

RECORD

Cased in., ft.Sand Gas Oil Total Depth

PRODUCTION

1st 24 hrs. Nat. 1st 24 hrs. after shot Gas Cu. Ft.Dry Hole Abandoned

Date

SEP 1 2 1945

19

S. J. LEWIS

Scout

KANSAS

Pool Name Kraft-Prusa pool

Map No. 155 Sec. 16 Twp. 17 R. 11W

Well No. 5 Grossardt

Lauck & Moncrief Company

COMPLETED

Contractor

SW NW NW

E11840
SECTION PLAT

990 Ft. from N. Line

_____ Ft. from S. Line

_____ Ft. from E. Line

330 Ft. from W. Line

0			

Barton County

Location _____

Rig up _____

Drilling and Remarks:

Core 3256

5" @ 3287

Pump 173 BT

42 @ 3287

RECORD

Cased _____ in., _____ ft.

Sand _____

Gas _____

Oil _____

Total Depth 2300

PRODUCTION

1st 24 hrs. Nat. _____

1st 24 hrs. after shot _____

Gas _____ Cu. Ft.

Dry Hole _____

Abandoned _____

Date

DEC 12 1945

19

S. J. LEWIS

Scout