

KANSAS


Barton

FORM 51 5M 10-41 PETROL

Section 17 Township 17 Range 11-W

Well No. #1 Radenberg

Company Brain & Goering

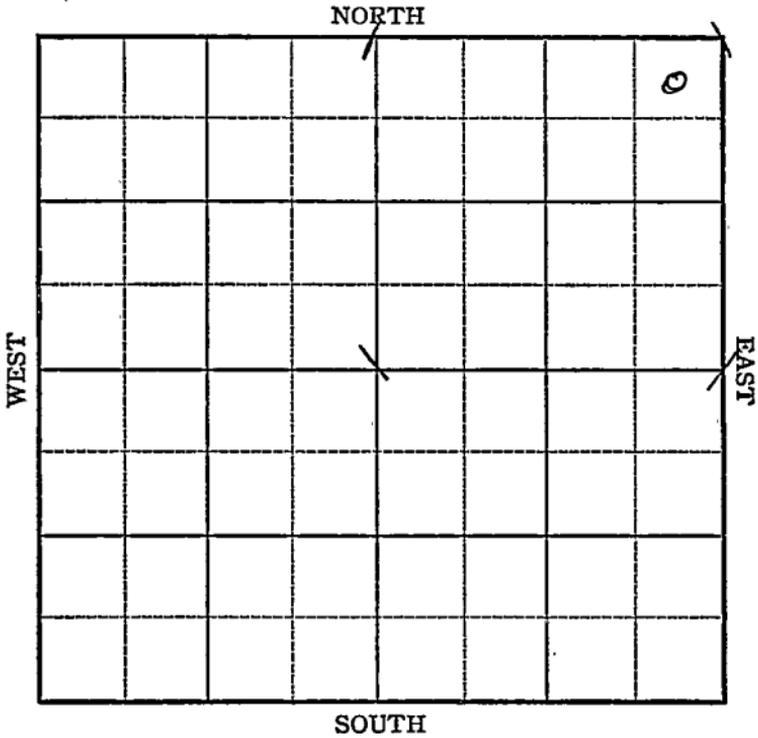

Sec. 17 Twp. 17 R. 11-W

Well No. #1 Radenberg Farm
Brain & Goering Company


Kraft Pruse

330 Ft. from N. Line

_____ Ft. from S. Line

330 Ft. from E. Line

_____ Ft. from W. Line

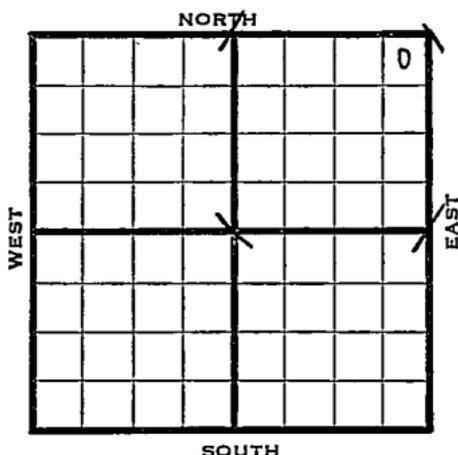

El. 1853

1943

REPORT

1/6	Location
1/13	"
1/20	"
1/27	"
2/3	8" @ 365' WOC
2/10	Drlg. 2100'
2/17	Arb 3303-05 TD 5" Casing set 3303 RUST & Sat.
2/24	TD 3305 Swab 12 oil per hrs 2 hrs
3/3	" " " " "
3/10	500 gals acid pump 25 bbls oil per hrs.
3/17	Arb. 3303' 5" @ 3303' T.D. 3305' 500 gal acid Pump 531 Pot. Gravity 43.6

COMPLETED

KANSAS

Map No. 55 Sec. 17 Twp. 17 R. 11W

Well No. 1 Radenberg

Brian & Goering Company

FIRST REPORT Contractor

NE/C


330 Ft. from N. Line

_____ Ft. from S. Line

330 Ft. from E. Line

_____ Ft. from W. Line

SECTION PLAT

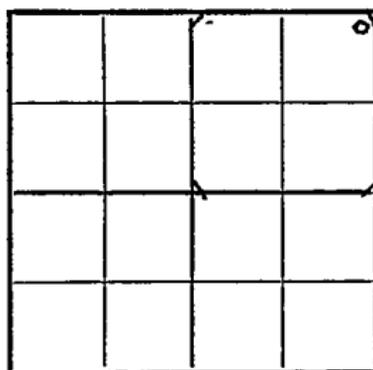

KRAFT PRUSA POOL

Location XXX

Rig up _____

Drilling and Remarks:

RECORD

Cased _____ in., _____ ft.

Sand _____

Gas _____

Oil _____

Total Depth _____

PRODUCTION

1st 24 hrs. Nat. _____

1st 24 hrs. after shot _____

Gas _____ Cu. Ft.

Dry Hole _____

Abandoned _____

Date

JAN 6 1943 19

S. J. LEWIS Scout

Barton

KANSAS

Map No. 25 Sec. 17 Twp. 17 R. 11W

Well No. 1 Radenberg

Brian & Goering Company

COMPLETED Contractor

NE/C

330 Ft. from N. Line

_____ Ft. from S. Line

330 Ft. from E. Line

_____ Ft. from W. Line

SECTION PLAT

			o

KRAFT PRUSA POOL

Location _____

Rig up _____

Drilling and Remarks:

Core 3303
5" @ 3303
500 acid
Pump 531 P.Y.

436 Su

RECORD

Cased _____ in., _____ ft.

Sand _____

Gas _____

Oil _____

Total Depth 3305

PRODUCTION

1st 24 hrs. Nat. _____

1st 24 hrs. after shot _____

Gas _____ Cu. Ft.

Dry Hole _____

Abandoned _____

Date

MAR 17 1943 19

S. J. LEWIS Scout