

Barton

KANSAS

Section 19 Township 17 Range 11W

Well No. #1 Huslig

Company Imperial Pet.

NORTH

WEST

EAST

				D			

SOUTH

Barton

KANSAS

Sec. 19 Twp. 17 R. 11W

Well No. #1 Huslig Farm

Imperial Pet. Company

Contractor

Wildcat


330' Ft. from N. Line

Ft. from S. Line

Ft. from E. Line

330' Ft. from W. Line

NW NW NE

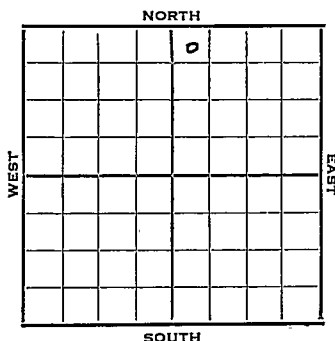


1951 Elev. 1864' REPORT

11/28 Spud 11-25-51
8" @ 317
WOC

12/12 Spud 11-25-51
D&A TD 3386
8" @ 317
Heeb. 2948
Br Lime 3052
Lans. 3068
DST 3070-3103 opn 1 $\frac{1}{4}$ hr.
Rec. 115' socm
DST 3147-55 opn 1 hr
Rec. 70' wtr 10' o & gcm
Cong. 3319 Arb. 3336-86 TD
D&A

ABANDONED

J. E. TYRÄ

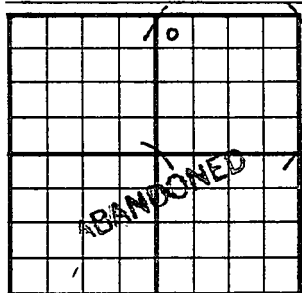County Barton State KansasSec. 19 (Blk.
Twp.) 17 (Sur.
Rge.) 11W Map No.Operator Imperial Pet.Well No. 1 Farm HusligElev. 1864 Location NW NW NE330 Ft. From N Line NE330 Ft. From W Line Quarter

1st. Report

Completion DEC 1 2 1951Remarks WildcatSpudding Date 11-25-51Drlg. Data D & A TD 33868" @ 317 Heeb. 2948 Br. lime 3052Lans. 3068 DST 3070-3103 open 1 $\frac{1}{4}$ hr.Rec. 115' socm DST 3147-55 open 1 hr.Rec. 70' water 10' o & gcm Cong. 3319Arb. 3336-86 TDD & A

J. E. TYRA