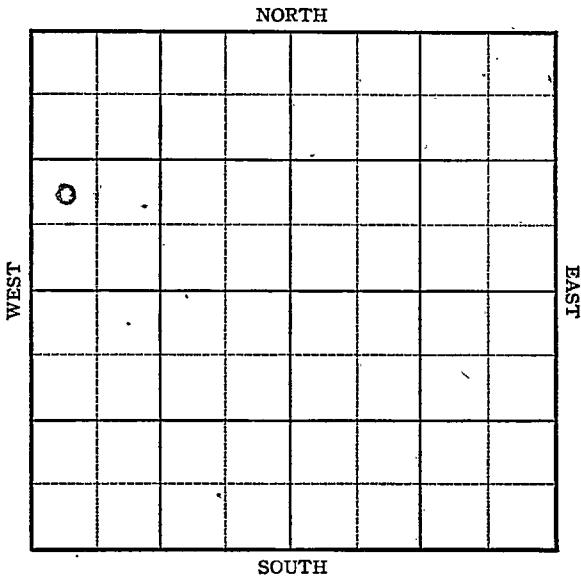


KANSAS

FORM 51 5M 11-44 PETROL

Section 19 Township 17 Range 11WWell No. #1 Huslig "B"Company Bridgeport

KANSAS

Barton


Sec. 19 Twp. 17 R. 11W

Well No. #1 Huslig "B" Farm

Bridgeport.

Company

Kraft-Prusa

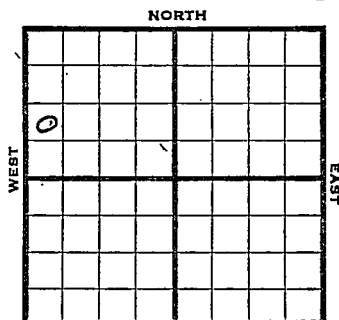

 Ft. from N. Line

990 Ft. from S. Line

 Ft. from E. Line

330 Ft. from W. Line

NW SW NW

Elev. 1857

SOUTH

1945

R E P O R T

2/21

8" - 300

Drlg 325

2/28

Drlg 2810

3/7

Lans 3065

Cong 3330

Drlg 3335

3/14

Arb.

3350

TD 3386

ABANDONED

Pool Name Kraft-PrusaMap No. 55 Sec. 19 Twp. 17 R. 11WWell No. 1 Huslig "B"Bridgeport


Company

FIRST REPORT

Contractor

NW SW NW

SECTION PLAT

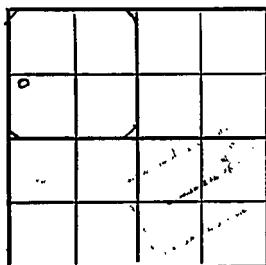 Ft. from N. Line990 Ft. from S. Line Ft. from E. Line330 Ft. from W. LineBartonLocation Rig up

Drilling and Remarks:

8" - 300325

RECORD

Cased in., ft.Sand Gas Oil Total Depth

PRODUCTION

1st 24 hrs. Nat. 1st 24 hrs. after shot Gas Cu. Ft. Dry Hole Abandoned

Date

FEB 21 194519S. J. LEWISScout

Pool Name Kraft-PrusaMap No. 55 Sec. 19 Twp. 17 R. 11WWell No. 1 Huslig "B"Bridgeport CompanyABANDONED Contractor

NW SW NW

SECTION PLAT

 Ft. from N. Line990 Ft. from S. Line Ft. from E. Line330 Ft. from W. Line

o			

BartonLocation Rig up

Drilling and Remarks:

Ar 3350

RECORD

Cased in., ft.Sand Gas Oil Total Depth 3386

PRODUCTION

1st 24 hrs. Nat. 1st 24 hrs. after shot Gas Cu. Ft.Dry Hole Abandoned

Date

MAR 14 1945 19 S. J. LEWIS Scout