


Section 21 Township 17 Range 11W

Well No. #1 Armbrust

Company Duke & Wood

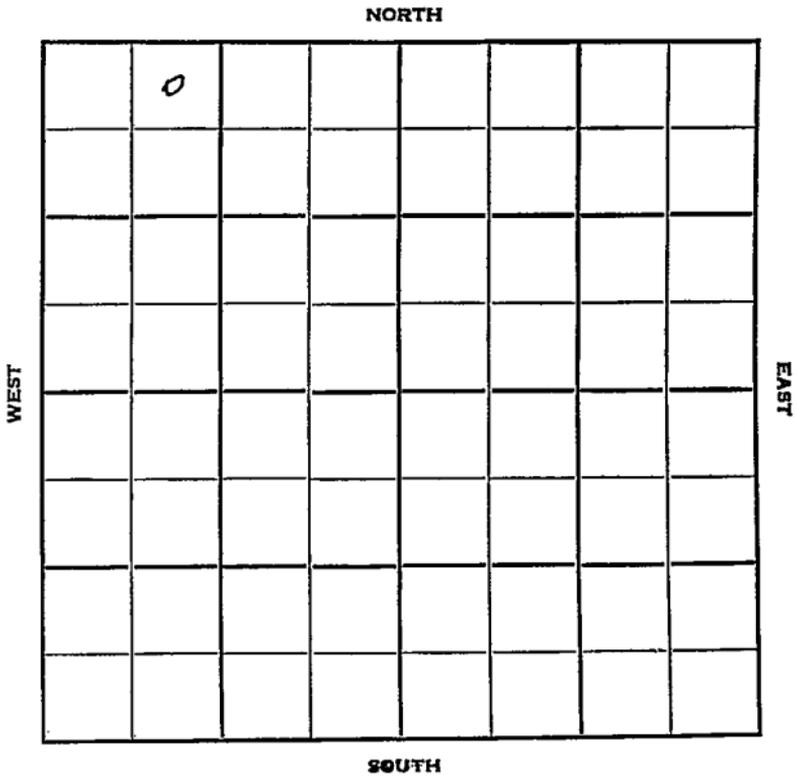

Barton
17

KANSAS

Sec. 21 Twp. 17 R. 11W

Well No. #1 Armbrust Farm

Duke & Wood Company

Duke & Wood - Contr. Contractor

Kraft Prusa


330' Ft. from N. Line

..... Ft. from S. Line

..... Ft. from E. Line

990' Ft. from W. Line

NE NW NW

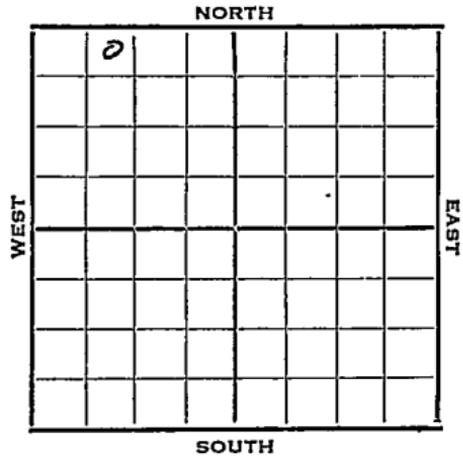

1951 Elev. 1819' REPORT

11/28 Spud 11-21-51
8" @ 268
Anhy 653
Drlg. 2200'

12/5 Spud 11-21-51
D&A TD 3300
8" @ 268
Anhy 653 Heeb. 2894
Br. Li 2997 Lans. 3014
TD 3300
D&A

ABANDONED

County Barton State Kansas

Sec. 21 (Blk. Twp.) 17 (Sur. Rge.) 11W Map No.

Operator Duke & Wood

Well No. 1 Farm Armbrust

Elev. _____ Location NE NW NW

| | | | | | |
|---|--|--|--|--|--|
| 0 | | | | | |
| | | | | | |
| | | | | | |
| | | | | | |
| | | | | | |
| | | | | | |

330 Ft. From N Line NW

990 Ft. From W Line Quarter

1st. Report NOV 28 1951

Completion _____

Remarks _____

Duke & Wood - Contr.

Spudding Date 11-21-51

Drig. Data Kraft & Prusa

8" @ 268 Anhy 653 Drig. 2200

J. E. TYRA

County Barton State Kansas

Sec. 21 (Blk. 17 (Twp.)) (Sur. 11W (Rge.)) Map No.

Operator Duke & Wood

Well No. 1 Farm Armbrust

Elev. 1819 Location NE NW NW

| | | | | | | |
|--|---|--|--|--|--|--|
| | o | | | | | |
| | | | | | | |
| | | | | | | |
| | | | | | | |
| | | | | | | |
| | | | | | | |
| | | | | | | |

ABANDONED

330 Ft. From N Line NW

990 Ft. From W Line Quarter

Ist. Report

Completion DEC 5 1951

Remarks Kraft-Prusa Pool

Duke & Wood - Contr.

Spudding Date 11-21-51

Drilg. Data D & A TD 3300

8" @ 268 Anhy 653 Heeb. 2894

Br. lime 2997 Lans. 3014 TD 3300

D & A

J. E. TYRA