KANSAS


FORM 51 5M BRIX

Barton County

Section 21 Township 17 Range 11W

Well No. #1 Armbrust

Company Derby

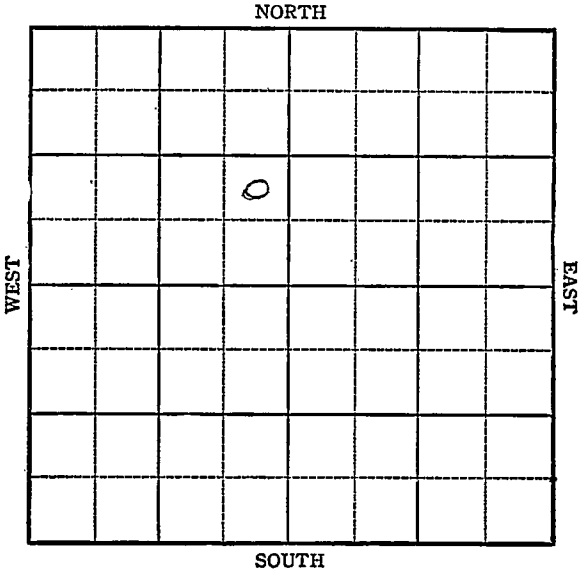

FORM 252-A
5M 9-44 PETROL

KANSAS Barton County

Sec. 21 Twp. 17 R. 11W

Well No. #1- Armbrust Farm

Derby Company


Kraft-Prusa

____ Ft. from N. Line

990 Ft. from S. Line

330 Ft. from E. Line

____ Ft. from W. Line

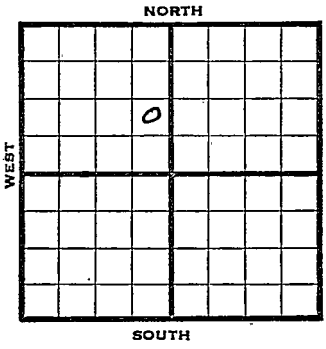

NE SE NW.

1944	REPORT
9/27	Location
10/4	"
10/11	"
10/18	8½ @ 359 WOC
10/25	Drlg. 948
11/2	Drlg. 2822
11/8	Lans 2986 Arb 3254 TD 3256 5" @ 3255 RUST
11/16	" " "
11/24	T D 3263---1000 accid
11/92	TD 3268½ 10 qt.s 3261 68½ Swb 10 oi oil in 3 hrs.
12/6	TD 3276' 1600 bbls oil in 9 hrs. 500 accid swb 25 fluid 1 hrs. 25% water.
12/14	" " " " " "
12/21	" " " " " "
12/29	" " " " " "

OVER

1945

1/10 Arb. 3254
5" @ 3255
10 qts 3261-68½
1500 acid
TD 3276
Pump 240 oil plus 19% wtr Pot
Grav. 42.0

COMPLETED

FORM 56 200 BKS. 1-44 PETROL

KANSAS

Pool Name Kraft-Prusa

Map No. J Sec. 21 Twp. 17 R. 11W


Well No. 1 Armbrust

Derby Company

FIRST REPORT Contractor

NE SE NW

SECTION PLAT

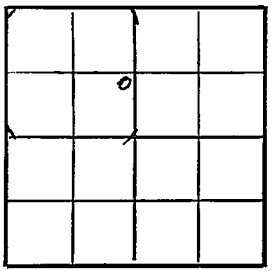

Ft. from N. Line

990 Ft. from S. Line

330 Ft. from E. Line

Ft. from W. Line

Barton County

Location X

Rig up

Drilling and Remarks:

RECORD

Cased in., ft.

Sand

Gas

Oil

Total Depth

PRODUCTION

1st 24 hrs. Nat.

1st 24 hrs. after shot

Gas Cu. Ft.

Dry Hole

Abandoned

Date

SEP 27 1944 19 S. J. LEWIS Scout

FORM 26 200 BKS 1 44 PETROL

Pool Name Kraft-Prusa

Map No. 55 Sec. 21 Twp. 17 R. 11W


Well No. 1 Armbrust

Derby Company

COMPLETED Contractor

NE SE NW

SECTION PLAT

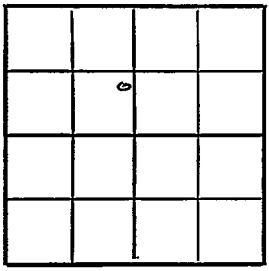

Ft. from N. Line

990 Ft. from S. Line

330 Ft. from E. Line

Ft. from W. Line

Barton

Location

Rig up

Drilling and Remarks:

Cr X 3205'4
5" C 3255'
10 @ 3261-68½
1500 Cecil
Pump. 240 oil +
19 @ Water B X

42 Gr

RECORD

Cased in., ft.

Sand

Gas

Oil

Total Depth 3276

PRODUCTION

1st 24 hrs. Nat.

1st 24 hrs. after shot

Gas Cu. Ft.

Dry Hole

Abandoned

Date

JAN 10 1945 19 S. J. LEWIS Scout