


Section 21 Township 17 Range 11W

Well No. 1 Soeken

Company Petroleum Inc. et al

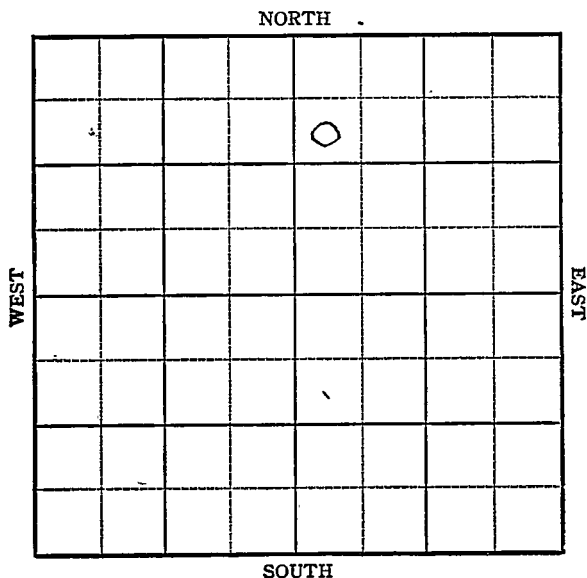

KANSAS

Barton

Sec. 21 Twp. 17 R. 11W ✓

Well No. #1 Soeken Farm

Petroleum Inc., et al Company

Kraft-Prusa Pool


990' Ft. from N. Line

_____ Ft. from S. Line

_____ Ft. from E. Line

330' Ft. from W. Line

SW NW NE

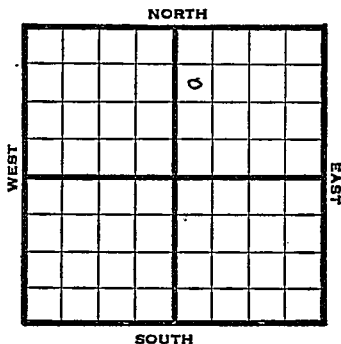

1948 Eli 1826' REPORT

7/28 Surface Hole

8/4 8" @ 206'
Drlg. 2930'

8/11 Lansing 3009'
Arbuckle 3273'
TD 3330'
5" @ 3330'

8/18 "

8/25 "

9/1 20 shots 3283-85 swb 13 bbls oil
& 13 W PH

9/8 " "

9/14 " "

9/21 " "

9/29 " "

10/6 " "

10/13 " "

10/19 " "

10/26 " "

11/3 " "

11/10 TD 3330'
Arb. 3272'
5" @ 3330'
Perf
Fump 25 oil / W Pot
42° Gr.
Comp

COMPLETED

Barton County Kansas State

Map No. _____ Sec. 21 Twp. 17 R. 11W

Well No. 1 Soeken

Petroleum Inc. etal. Company

FIRST REPORT

Contractor

SW NW NE

SECTION PLAT

990 Ft. from N. Line

_____ Ft. from S. Line

_____ Ft. from E. Line

330 Ft. from W. Line

Kraft-Prusa Pool

Remarks:

surface hole

Date JUL 28 1948

Scout S. J. LEWIS

Kansas

Map No. 55 Sec. 21 Twp. 17 R. 11W

Well No. 1 Soeken

Petroleum Inc. etal. Company

COMPLETE

Contractor

SW NW NE

E. 11/26

SECTION PLAT

990 Ft. from N. Line

 Ft. from S. Line

 Ft. from E. Line

330 Ft. from W. Line

Barton County

Location

Rig up

Drilling and Remarks:

See #3279

5" C3230

Prof.

Pump 25' oil + W

Prod

420/32

RECORD

Cased in., ft.

Sand

Gas

Oil

Total Depth 3330

PRODUCTION

1st 24 hrs. Nat.

1st 24 hrs. after shot

Gas Cu. Ft.

Dry Hole

Abandoned

Date

NOV 10 1940 19

S. J. LEWIS Scout