


KANSAS

Section 21 Township 17 Range 11W

Well No. 10 - Soeken

Company Isern Drlg

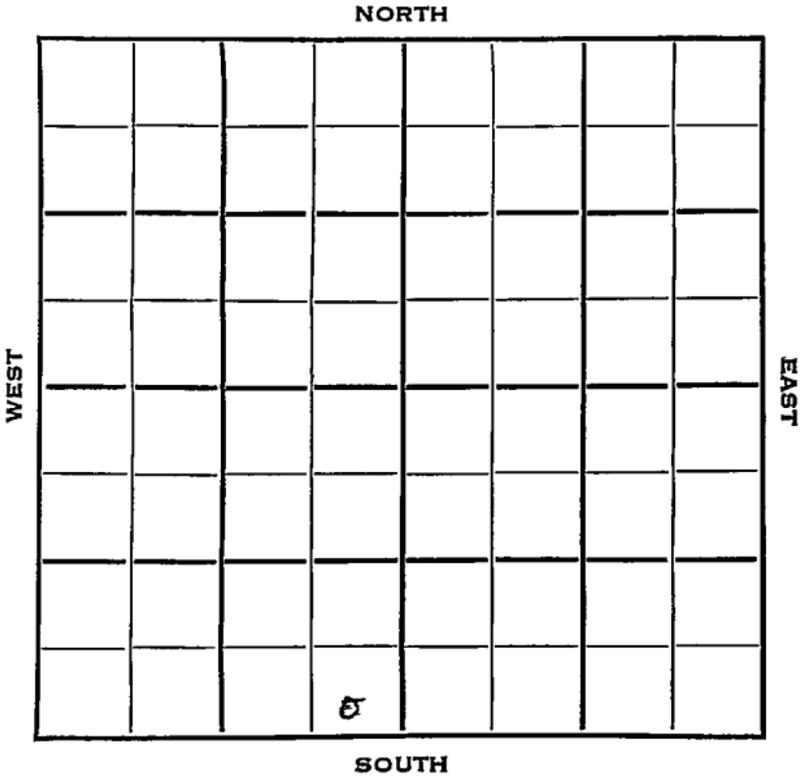

Barton
17

KANSAS ✓
11W

21

Sec. _____ Twp. _____ R. _____

#1 Soeken

Well No. _____ Farm _____

Isern Drlg.

Company _____

Contractor _____

_____ Ft. from N. Line

330


_____ Ft. from S. Line

330

_____ Ft. from E. Line

_____ Ft. from W. Line

SE SE SW

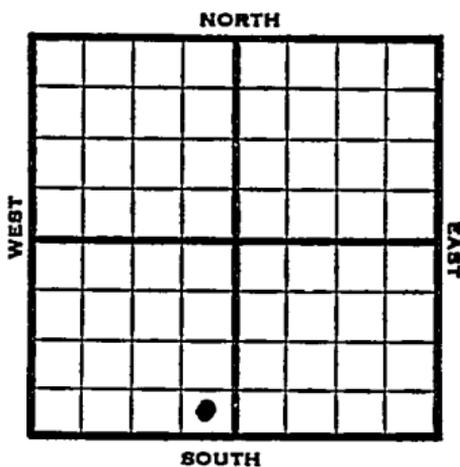

1953

Elev. 1821' REPORT

121

Spud 1-17-53
8" @ 195
Anhy 650
Drlg. 1526'

1/28

Spud 1-17-53
D&A
TD 3319
8" @ 195
Anhy 650, Heeb 2902, Tor 2923,
B. Oread 2934, Br lime 3011,
Lans 3027, Cong 3285, Arb.
3306
TD 3319
D&A

ABANDONED

