

# KANSAS

Barton


FORM 51 5M 1-42 PETROL

Section 21 Township 17 Range 11-W

Well No. #1 Soeken "B"

Company Shell

NORTH Kraft-Prusa Pool

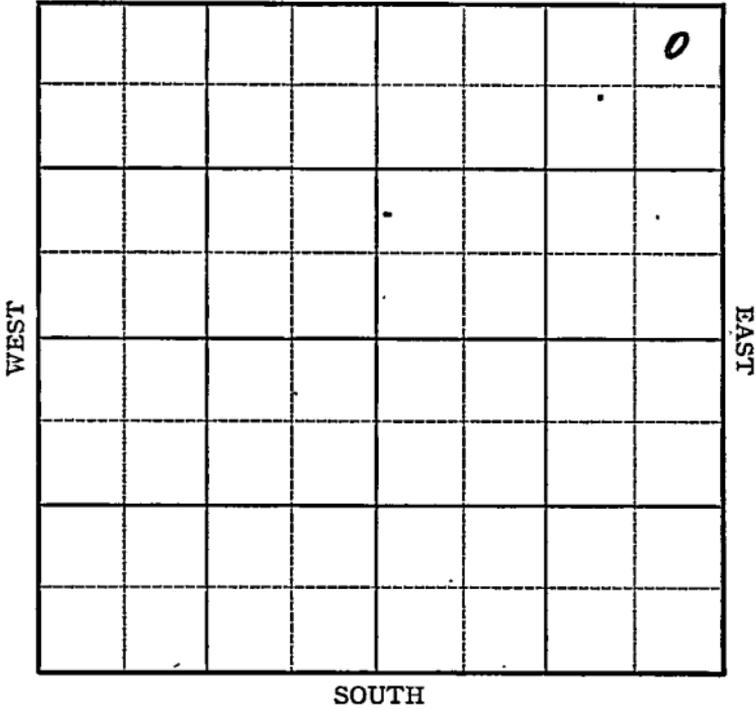

Sec. 21 Twp. 17 R. 11-W

Well No. #1 Soeken "B" Farm

Shell Company

(Kraft - Prusa)


330 Ft. from N. Line

\_\_\_\_\_ Ft. from S. Line

330 Ft. from E. Line

\_\_\_\_\_ Ft. from W. Line

*Elv. 1837*

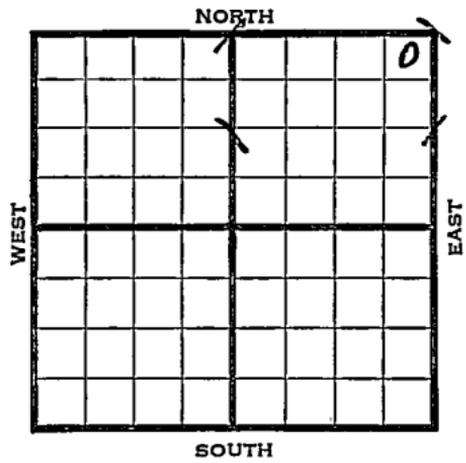

1942	REPORT
2/4	8" - 334'
	Drlg. 1900'
2/12	Topeka 2637' Lans. 3010'
	T.D. 3272' Run 4".
2/19	Arb. 3269' 4" - 3270' T.D. 3277'
	Swab 330 oil in 4 hours.
2/25	Arb. 3269'
	4" - 3270'
	T.D. 3277'
	Depthograph potential 10,448 bbls.
	Maximum 3000 bbls.
	43.6 Gravity
	<b>COMPLETED</b>

Map No. 55 Sec. 21 Twp. 17 R. 11WWell No. 1 Soeken "B"Shell

Company

**FIRST REPORT**

Contractor

NE/C


## SECTION PLAT

330 Ft. from N. Line

\_\_\_\_\_ Ft. from S. Line

330 Ft. from E. Line

\_\_\_\_\_ Ft. from W. Line

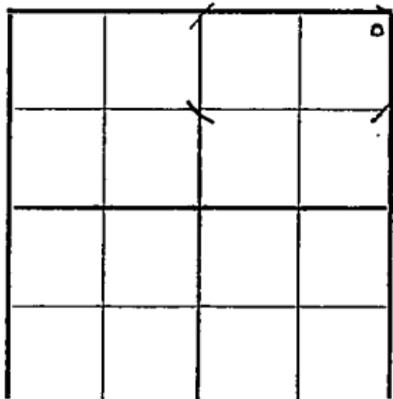

KRAFT-PRUSA POOL

## RECORD

Location \_\_\_\_\_

Cased \_\_\_\_\_ in., \_\_\_\_\_ ft.

Rig up \_\_\_\_\_

Sand \_\_\_\_\_

Drilling and Remarks:

Gas \_\_\_\_\_

8" - 334'

Oil \_\_\_\_\_

1900' Drilling.

Total Depth \_\_\_\_\_

## PRODUCTION

1st 24 hrs. Nat. \_\_\_\_\_

1st 24 hrs. after shot \_\_\_\_\_

Gas \_\_\_\_\_ Cu. Ft.

Dry Hole \_\_\_\_\_

Abandoned \_\_\_\_\_

Date

FEB 4 1942 19S. J. LEWIS Scout

Barton

KANSAS

Map No. 55 Sec. 21 Twp. 17 R. 11W

Well No. 1 Soeken "B"

Shell Company

COMPLETED Contractor

NE/C

SECTION PLAT

330 Ft. from N. Line

\_\_\_\_\_ Ft. from S. Line

330 Ft. from E. Line

\_\_\_\_\_ Ft. from W. Line

			o

KRAFT PRUSA POOL

Location \_\_\_\_\_

Rig up \_\_\_\_\_

Drilling and Remarks:

*Cor of 3269*  
*# " @ 3270*  
*Depth of 10448*  
*Max 3000*  
*43 6 Gr*

RECORD

Cased \_\_\_\_\_ in., \_\_\_\_\_ ft.

Sand \_\_\_\_\_

Gas \_\_\_\_\_

Oil \_\_\_\_\_

Total Depth 3277

PRODUCTION

1st 24 hrs. Nat. \_\_\_\_\_

1st 24 hrs. after shot \_\_\_\_\_

Gas \_\_\_\_\_ Cu. Ft.

Dry Hole \_\_\_\_\_

Abandoned \_\_\_\_\_

Date

FEB 25 1942 19

S. J. LEWIS Scout