Barton

SECTION 21 TOWNSHIP 17 KANSAS RANGE 11W

WELL NO. #1 Soeken "B"

COMPANY Shell Oil Co.

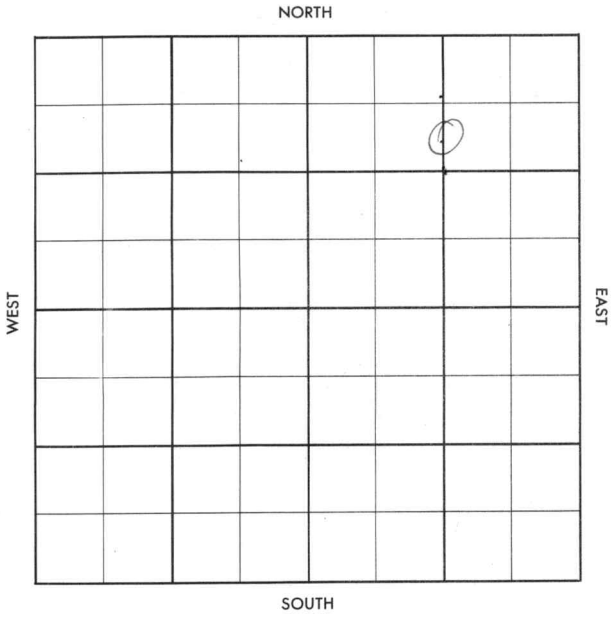

FORM 504-3 SUNRAY

FORM 513 SUNRAY

County Barton Elev.

Sec. 21 Twp. 17 Rge. 11W

Company Shell Oil Co.

Farm Name Soeken "B" No. 1

TOPS	DEPTH	LOG	DATUM
Anh.			
Tp.			
H.			
Tr.			
Dg.			
Bl.			
L.			
K.C.			
B.K.C.			
Ce.			
C.			
M.			
M.			
K.			
Mz.			
Mo.			
V.			
S.			
S.			
A			
R.			
P€.			
G.			
T.D.			

Loc. in Sec. C S/2 N/2 NE

Geol.

Contr. C&P

Pool Kraft-Prusa



FIRST REPORT

Date Comm. OCT 10 '56

Co. Lse. No. Sec. T. R.

FORM 513 SUNRAY

SWD

County Barton Elev.

Sec. 21 Twp. 17 Rge. 11W

Company Shell Oil Co.

FarmName Soeken "B" No. 1

TOPS	DEPTH	LOG	DATUM
Anh.			
Tp.		2612	
H.			
Tr.			
Dg.			
B.L.			
L.		2986	
K.C.			
B.K.C.			
Ce.			
C.			
M.			
M.			
K.			
Mz.			
Mo.			
V.			
S.			
S.			
A		3240	
R.			
P€.		3544	
G.			
T.D.	3576		

Loc. in Sec. C S/2 N/2 NE

Geol.

Contr. C&P

Pool Kraft-Prusa

NOV 20 '56

COMPLETE

Co. Lse. No. Sec. T. R.

Date Comm.

OCT 17 '56 10-10-56 8 13 3/8

352/362 ⌀ 2116 OCT 24 '56

⌀ 2853 OCT 31 '56 5½ @ ~~3350~~ NOV 7 '56

8 5/8 @ 3349/450 RWT NOV 13 '56 CO

3576 30 NOV 21 '56 ✓ NOV 28 '56 Input

1010 ~~Depth~~ BWPH comps.

for SWD Well.