

Barton KANSAS

SEC.	TWP.	R.
21	17	11W

WELL NO. 1 Soeken "C" FARM

COMPANY Heathman & Seeligson

CONTRACTOR Co. Tools


SW Kraft-Prusa Pool

990 Ft. from N. Line

Ft. from S. Line

Ft. from E. Line

990 Ft. from W. Line

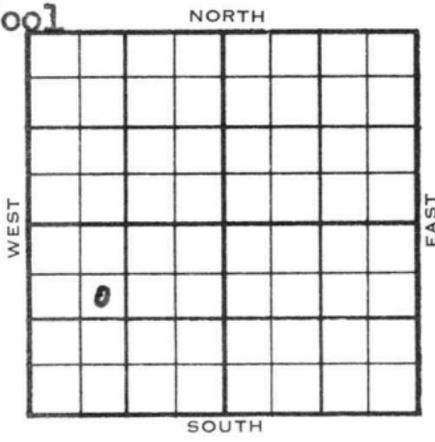

SE NW SW

	ELEVATION	REPORT
1954	1830'	

11/10 Spud 11-5-54
8" @ 240'
Drlg. 1850'

11/23 Spud 11-5-54
D & A
TD 3327'
8" @ 240'
Heeb 2915', Tor 2930', Doug 2948', Br.
Lime 3023' Lans 3037'
DST 3065'-3115' opn 1 hr, rec 20' Mud
120# Cong 3295'
TD 3327'
D & A

ABANDONED

County **Barton** State **Kansas**

Sec. **21** (Blk. Twp.) **17** (Sur. Rge.) **11W** Map No.

Operator **Heathman & Seeligson**

Well No. **1** Farm **Soeken "C"**

Elev. Location **SE NW SW**

FIRST REPORT					

990 Ft. From **N** Line **SW**

990 Ft. From **W** Line Quarter

1st. Report **NOV 10 1954**

Completion

Remarks

Co. tools

Spudding Date **11-5-54**

Drlg. Data **SW Kraft-Prusa Pool**

8" @ 240 drlg. 1850

FABEN GILSTRAP

County Barton State Kansas

Sec. 21 (Blk. 17) (Sur. 11W) (Twp.) (Rge.) Map No.

Operator Heathman & Seeligson

Well No. 1 Farm Soeken "C"

Elev. 1830 Location SE NW SW

990 Ft. From N Line SW

990 Ft. From W Line Quarter

1st. Report

Completion NOV 23 1954

Remarks SW Kraft-Prusa Pool

Co. tools

Spudding Date 11-5-54

Drlg. Data D & A TD 3327

8" @ 240 Heeb. 2915 Tor. 2930

Doug. 2948 Br. lime 3023 Lans. 3037

DST 3065-3115 open 1 hr. Rec. 20' mud

120# Cong. 3295 TD 3327

D & A

FABEN G...