KANSAS
FORM 51 5M 10-41 PETROL


Barton

Section 21 Township 17 Range 11-W

Well No. #2 Soeken

Company Gulf

Kraft Prusa Pool

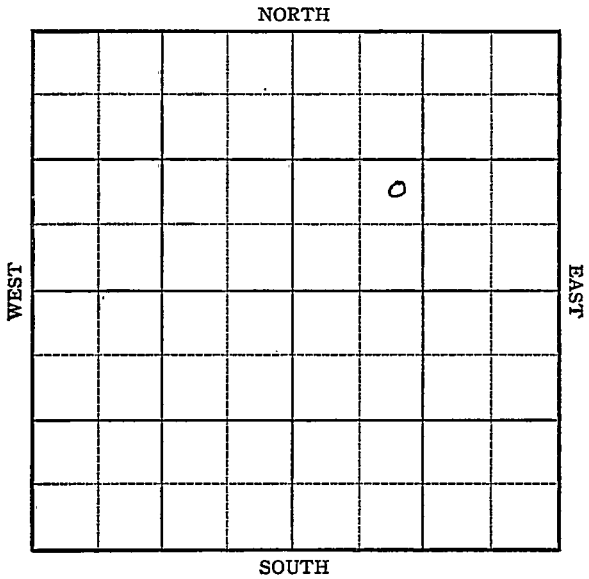

Form 252-A
5M 5-42 Petrol

KANSAS Barton

Sec. 21 Twp. 17 R. 11-W

Well No. #2 Soeken Farm

Gulf Company


(Kraft Prusa Pool)

1735 Ft. from N. Line

Ft. from S. Line

1650 Ft. from E. Line

Ft. from W. Line

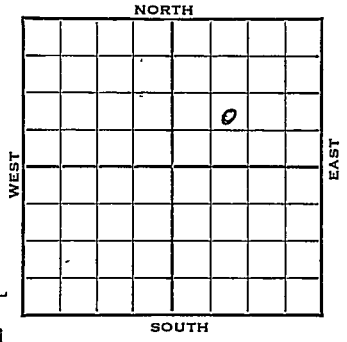

Elev. 1801

1942	REPORT
7/29	Drlg. 200' 8" - 196' Waiting on cement.
8/5	Drlg. 2861'
8/12	Arb. 3240, 5" @ 3241 TD 3255 swab 119 oil in 2½ hrs.
8/19	Arb. 3240' 5" - 3241 TD 3255' Somimeter Pot. 5522 Max. 3000 Gravity 43.6 COMPLETED

Form 26 200 Bks. 5-41 McW. Barton KANSAS

Map No. S-S Sec. 21 Twp. 17 R. 11W

Well No. 2 Soeken

Gulf Company

FIRST REPORT Contractor

NE SW NE

1735 Ft. from N. Line


____ Ft. from S. Line

1650 Ft. from E. Line

____ Ft. from W. Line

KRAFT PRUSA POOL

SECTION PLAT

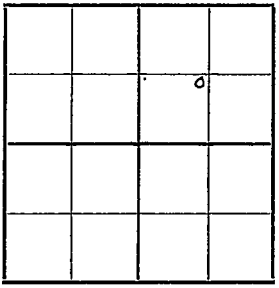

Location

Rig up

Drilling and Remarks:

Drlg. 200'

8" - 196'

Waiting on cement

RECORD

Cased ____ in., ____ ft.

Sand

Gas

Oil

Total Depth

PRODUCTION

1st 24 hrs. Nat.

1st 24 hrs. after shot

Gas ____ Cu. Ft.

Dry Hole

Abandoned

Date

JUL 29 1942 19

S. J. LEWIS Scout

Form 26 200 Bks 5-42 Petrol

Barton KANSAS

Map No. 55 Sec. 21 Twp. 17 R. 11W

Well No. 2 Soeken

Gulf Company

COMPLETED Contractor

NE SW NE


1735 Ft. from N. Line

_____ Ft. from S. Line

1650 Ft. from E. Line

_____ Ft. from W. Line

SECTION PLAT

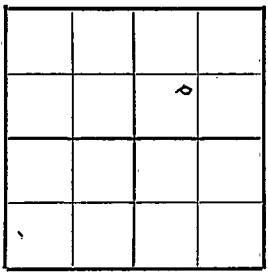

KRAFT PRUSA POOL

Location

Rig up

Drilling and Remarks:

Cr Y3240

5"C 3241

Sonic mc Tes Pat.

5522 Map 3900

48 & Gr.

RECORD

Cased ____ in., ____ ft.

Sand

Gas

Oil

Total Depth 3255

PRODUCTION

1st 24 hrs. Nat.

1st 24 hrs. after shot

Gas ____ Cu. Ft.

Dry Hole

Abandoned

Date

AUG 19 1942 19

S. J. LEWIS Scout