KANSAS

FORM 51 5M 4-41 PETROL


Barton

Section 21 Township 17 Range 11-W

Well No. #2 Soeken "A"

Company Vickers

Kraft Prusa Pool

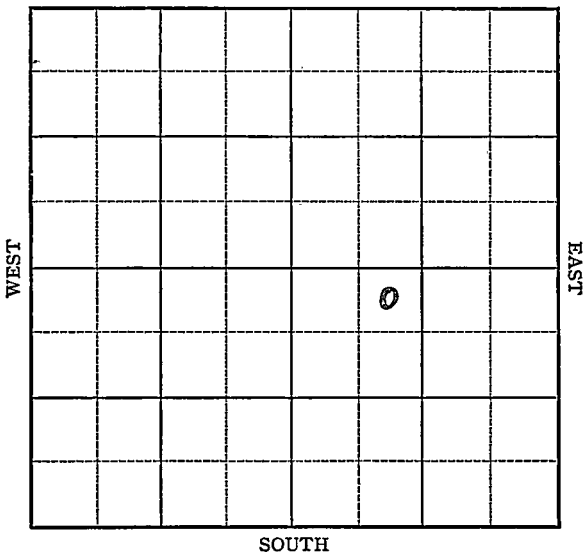

FORM 252-A
5M 10-41 PETROL

KANSAS

Barton

Sec. 21 Twp. 17 R. 11-W

Well No. #2 Soeken "A" Farm

Vickers Company


(Kraft Prusa)

330 Ft. from N. Line

_____ Ft. from S. Line

_____ Ft. from E. Line

990 Ft. from W. Line

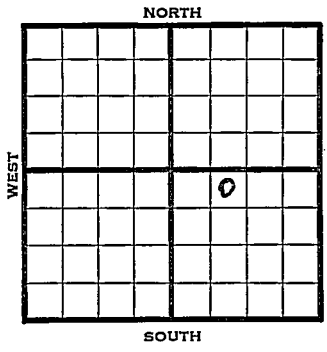

Elev. 1797

1942	REPORT
6/10	Derrick.
6/17	10" - 302' WOC.
6/24	Lans. 3084' Arb. 3246' T.D. 3256'
	S.O. Run 5".
7/1	5" - 3246' 1700' oil 36 hours.
7/8	" " "
7/15	Arb. 3246'
	5" - 3246'
	T.D. 3256'
	7000 acid.
	Pump 401 oil & 7% water.
	42. Gravity
	COMPLETED

Form 26 200 Bks. 5-41 McW.

Barton KANSAS

Map No. 55 Sec. 21 Twp. 17 R. 11W

Well No. 2 Soeken "A"

Vickers Company

FIRST REPORT Contractor

NE NW SE


330 Ft. from N. Line

____ Ft. from S. Line

____ Ft. from E. Line

990 Ft. from W. Line

SECTION PLAT

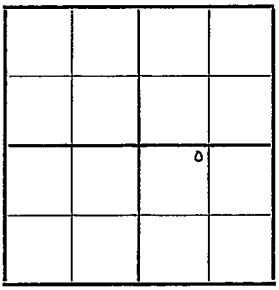

KRAFT PRUSA POOL

Location

Rig up

Drilling and Remarks:

Derrick

RECORD

Cased ____ in., ____ ft.

Sand

Gas

Oil

Total Depth

PRODUCTION

1st 24 hrs. Nat.

1st 24 hrs. after shot

Gas ____ Cu. Ft.

Dry Hole

Abandoned

Date

JUN 10 1942 19

S. J. LEWIS Scout

Form 26 200 Bks. 5-41 McW. Barton KANSAS

Map No. 55 Sec. 21 Twp. 17 R. 11W

Well No. 2 Soeken "A"

Vickers Company

COMPLETED Contractor

NE NW SE


330 Ft. from N. Line

____ Ft. from S. Line

____ Ft. from E. Line

990 Ft. from W. Line

SECTION PLAT

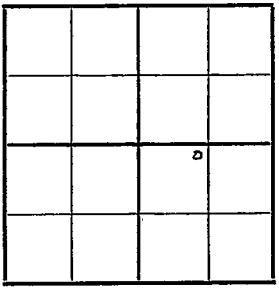

KRAFT PRUSA POOL

Location

Rig up

Drilling and Remarks:

Ac & 3246
5" @ 3246
7000 Acid.
Pump 40 oil &
7% Water
42° Gr

RECORD

Cased ____ in., ____ ft.

Sand

Gas

Oil

Total Depth 3256

PRODUCTION

1st 24 hrs. Nat.

1st 24 hrs. after shot

Gas ____ Cu. Ft.

Dry Hole

Abandoned

Date

JUL 15 1942 19

S. J. LEWIS Scout