

CONFIDENTIAL

SIDE ONE

KCC

STATE CORPORATION COMMISSION OF KANSAS
OIL & GAS CONSERVATION DIVISION
WELL COMPLETION FORM
ACO-1 WELL HISTORY
DESCRIPTION OF WELL AND LEASE

Operator: License # 4959Name: ZPC Petroleum, Inc.Address 9319 East Harry - Suite 122City/State/Zip Wichita, KS 67207Purchaser: Clear Creek, Inc.Operator Contact Person: Zeb StewartPhone (316) 683-8838Contractor: Name: Duke Drilling Co., Inc.License: 5929Wellsite Geologist: ZEB Stewart

Designate Type of Completion

☒ New Well ☐ Re-Entry ☐ Workover☒ Oil ☐ SWD ☐ Temp. Abd.☐ Gas ☐ Inj ☐ Delayed Comp.☐ Dry ☐ Other (Core, Water Supply, etc.)If ~~OWO~~: old well info as follows:

Operator: _____

Well Name: _____

Comp. Date _____ Old Total Depth _____

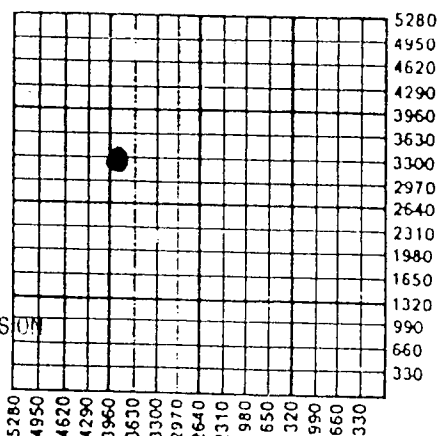
Drilling Method:

☒ Mud Rotary ☐ Air Rotary ☐ Cable

10-16-90 10-25-90 11-21-90
Spud Date Date Reached TD Completion Date

API NO. 15- 135-23,510

FEB 1

County NessW/2W/2SENW Sec. 32 Twp. 16S Rge. 24W ☒ East ☒ West3300' Ft. North from Southeast Corner of Section3795' Ft. West from Southeast Corner of Section
(NOTE: Locate well in section plat below.)Lease Name Dubbs Well # 3-32Field Name WildcatProducing Formation Mississippian DolomiteElevation: Ground 2502' KB 2511'Total Depth 4550' PBTD 4530'

FEB 19 1991

RECEIVED

STATE CORPORATION COMMISSION

APR 18 1991

CONSERVATION DIVISION
Wichita, KansasAmount of Surface Pipe Set and Cemented at 265 FeetMultiple Stage Cementing Collar Used? ☐ Yes ☒ No

If yes, show depth set _____ Feet

If Alternate II completion, cement circulated from 265 to 1750feet depth to surface w/ 125 490 sx cmt.

INSTRUCTIONS: This form shall be completed in triplicate and filed with the Kansas Corporation Commission, 200 Colorado Derby Building, Wichita, Kansas 67202, within 120 days of the spud date of any well. Rule 82-3-130, 82-3-107 and 82-3-106 apply. Information on side two of this form will be held confidential for a period of 12 months if requested in writing and submitted with the form. See rule 82-3-107 for confidentiality in excess of 12 months. One copy of all wireline logs and drillers time log shall be attached with this form. ALL CEMENTING TICKETS MUST BE ATTACHED. Submit CP-4 form with all plugged wells. Submit CP-111 form with all temporarily abandoned wells. Any recompletion, workover or conversion of a well requires filing of ACO-2 within 120 days from commencement date of such work.

All requirements of the statutes, rules and regulations promulgated to regulate the oil and gas industry have been fully complied with and the statements herein are complete and correct to the best of my knowledge.

Signature Zeb StewartTitle President Date 2-1-91Subscribed and sworn to before me this 1st day of February, 19 91.Notary Public D. W. E. Jr.Date Commission Expires 11/18/93

K.C.C. OFFICE USE ONLY

F ☒ Letter of Confidentiality Attached
C ☒ Wireline Log Received
C ☒ Drillers Timelog Received

Distribution

☒ KCC ☐ SWD/Rep ☐ NGPA
☒ KGS ☐ Plug ☒ Other (Specify)