

Map No. K Sec. 32 Twp. 25 R. 5


Well No. 65 Pierpont Farm
Empire Company

990 Ft. from N. Line

_____ Ft. from S. Line

330 Ft. from E. Line

_____ Ft. from W. Line

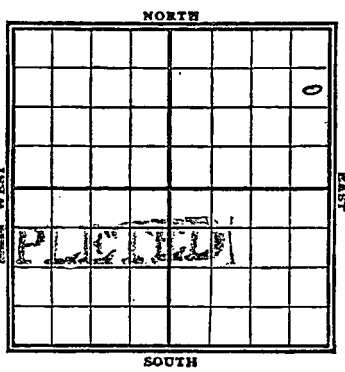

COMPLETION

1917
Date

REPORT


8/21 J. O. M.

1/17/20 Sand 2412'-26'

5/1/20 ~~2412-26~~ 10 day test

5/1/20 2412-26 - 45 fls.

Map No. K14 Sec. 32 Twp. 25 R. 5
Well No. 65 Pierpont Farm
Empire Company
NORTH

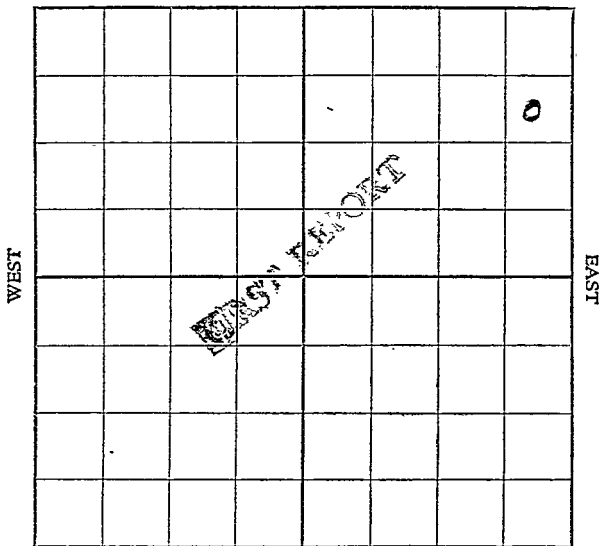

990 N SOUTH 330 E

Location

Rig up

Drilling and Remarks:

J. O. G.

RECORD

Cased..... in..... Ft.

Sand

Gas

Oil

Total Depth.....

PRODUCTION

1st 24 hrs. Nat.....

1st 24 hrs. after shot.....

Gas..... Cu. Ft.

Dry Hole

Abandoned

Date

8/21

, 191 9,

Payle

Scout

Map No. K14 Sec. 32 Twp. 25 R. 5

Well No. 65 Pierpont
Empire Company

Contractor _____

SECTION PLAT

990 Ft. from N. Line

_____ Ft. from S. Line

330 Ft. from E. Line

_____ Ft. from W. Line

COMPLETED

Location _____

Rig up _____

Drilling and Remarks:

RECORD

Cased _____ in., _____ ft.

Sand 2412 - 26

Gas _____

Oil _____

Total Depth _____

PRODUCTION

1st 24 hrs. Nat. 45 bbls

1st 24 hrs. after shot _____

Gas _____ Cu. Ft.

Dry. Hole _____

Abandoned _____

Date

5/26 1920

Pyle

Scout