


Section 32 Township 25 Range 5 E

Well No. # 93 Pierpont (*Pierpoint*)

Company Cities Service Oil

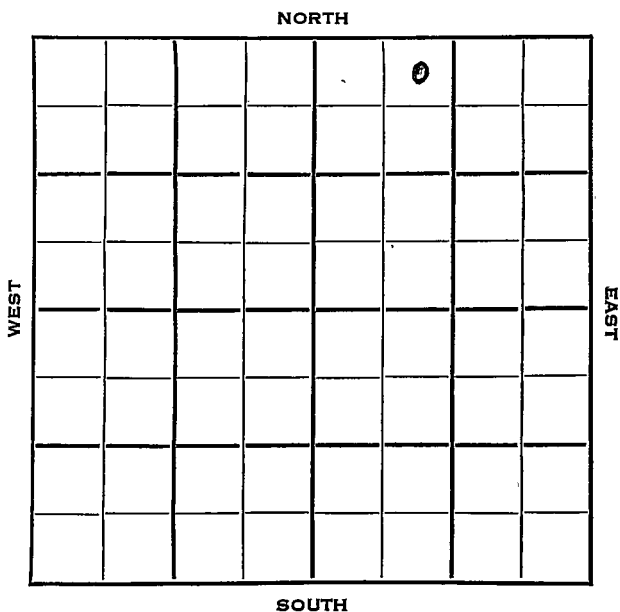

Butler

KANSAS ✓

Sec. 32 Twp. 25 R. 5 E

Well No. # 93 Pierpont Farm

Cities Service Oil Company

Contractor


330 Ft. from N. Line

\_\_\_\_\_ Ft. from S. Line

\_\_\_\_\_ Ft. from E. Line

990 Ft. from W. Line

NE NW NE

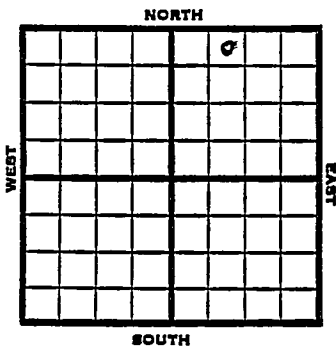

1953

Elev. 1370'

REPORT

8/12

Oil well TD 2460' Doug. 1508  
 Lans 1663 KC 1964 B KC 2132  
 Simp 2403 Arb. 2454  
 TD 2456 7" @ 2455 DD 2460  
 FU 1800' wtr. PB 2448 24/2419-22  
 36/2401-04 Hydro.  
 Comp. 4 BOPD 48 BW

FIRST REPORT

*Y*  
COMPLETED

County Butler State Kansas

Sec. 32 (Blk. Twp.) 25 (Sur. Rge.) 5E Map No.

Operator Cities Service Oil

Well No. 93 Farm Pierpont

Elev. 1370 Location NE NW NE

			0		

**FIRST REPORT**  
*(Handwritten mark)*  
**COMPLETE**

330 Ft. From N Line NE

990 Ft. From W Line Quarter

Ist. Report AUG 12 1953

Completion AUG 12 1953

Remarks

Spudding Date

Drlg. Data Oil well TD 2460

Doug. 1508 Lans. 1663 KC 1964

B KC 2132 Simp. 2403 Arb. 2454

TD 2456 7" @ 2455 DD 2460 FU 1800\* wtr.

PB 2448 24/ 2419-22 36/ 2401-04

Hydro. Comp. 4 bopd 48 bw