


Map No. *K14* Sec. *33* Twp. *25^S* R. *5^E*

Well No. *53 Pierpont*
Empire G. & F. Company

Contractor

NORTH

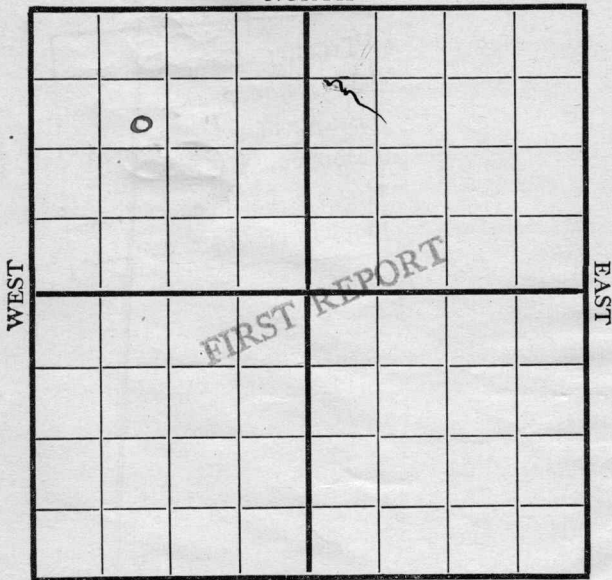

1010 N.-W. SOUTH

Location

Rig up

Drilling and Remarks:

Spudding

RECORD

Cased..... in.,ft.

Sand.....

Gas.....

Oil.....

Total Depth.....

PRODUCTION

1st 24 hrs. Nat.

1st 24 hrs. after shot

Gas..... Cu. Ft.

Dry Hole.....

Abandoned.....

Date

Jan 21 191*9*

Pyle

Scout

Map No. K14 Sec. 33 Twp. 25 R. 5

Well No. 53 Pierpont
Empire Company
Contractor

NORTH

WEST

EAST

	0						

1010 N-W SOUTH

RECORD

Location _____

Cased _____ in., _____ ft.

Rig up _____

Sand _____

Drilling and Remarks:

Gas _____

Oil _____

Total Depth _____

PRODUCTION

1st 24 hrs. Nat. _____

1st 24 hrs. after shot _____

Gas _____ Cu. Ft.

Dry Hole _____

Abandoned _____

Date

3/8 1919

Pyle


Scout

Map No. K14 Sec. 33 Twp. 25 R. 5

Well No. 53 Pierpont
Empire Company

Contractor

NORTH

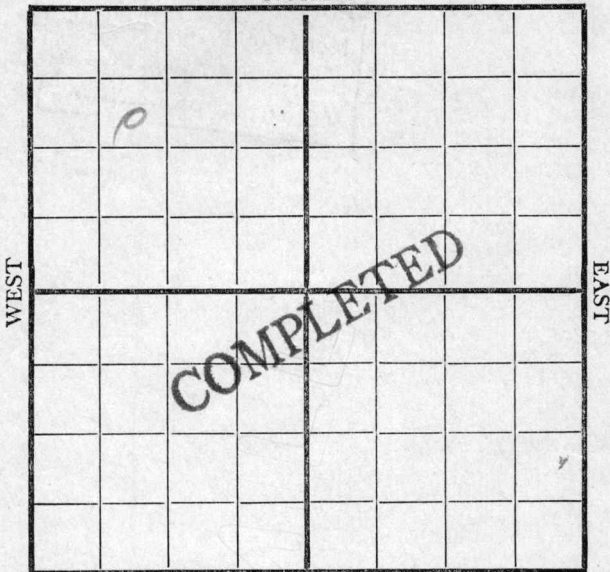

1010 N-W SOUTH

RECORD

Location _____

Cased _____ in., _____ ft.

Rig up _____

Sand 2417 - 2431

Drilling and Remarks:

Gas _____

Oil _____

Total Depth _____

PRODUCTION

1st 24 hrs. Nat. 100 bbls

1st 24 hrs. after shot _____

Gas _____ Cu. Ft.

Dry Hole _____

Abandoned _____

Date

3/20 1919

Pyle Scout