


**KANSAS**

Section 21 Township 17 Range 11W

Well No. #4 Soeken "A"

Company Vickers

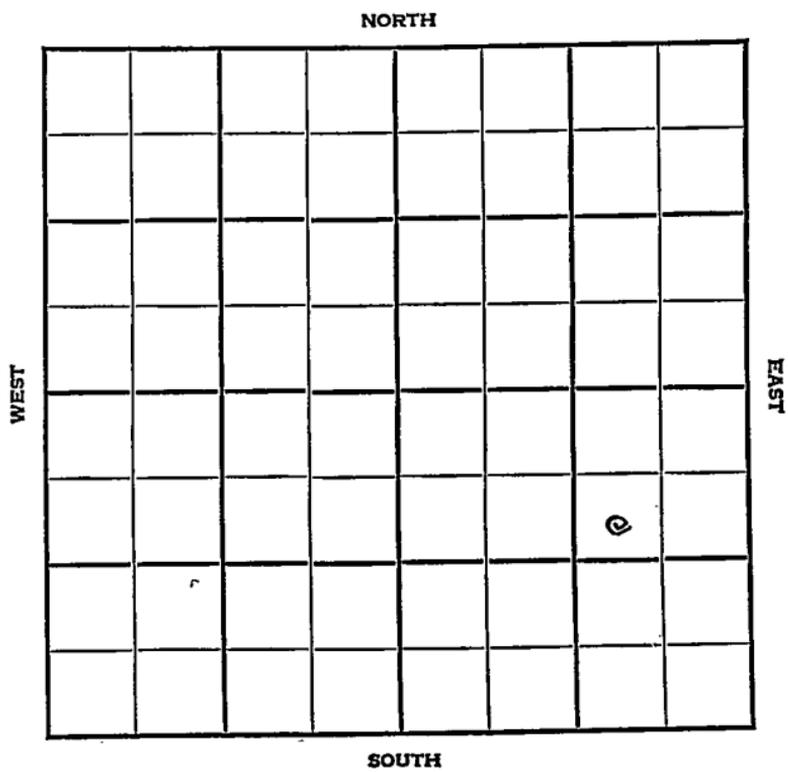

Sec. 21 Twp. 17 R. 11W

Well No. #4 Seeken "A" Farm

Vickers Company


Kraft-Prusa Pool

990 Ft. from N. Line

\_\_\_\_\_ Ft. from S. Line

990 Ft. from E. Line

\_\_\_\_\_ Ft. from W. Line

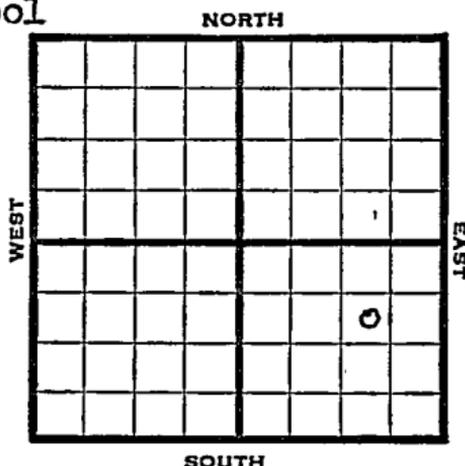

SW NE SE

1948

Elev. 1878'

REPORT

1/28

RUR

2/4

8" @ 300'  
Drlg. 1800'

2/11

Lans. 3011'  
Congl. 3260'  
Arb. 3280'  
TD 3292'  
Abd.

**ABANDONED**

Map No. \_\_\_\_\_ Sec. 21 Twp. 17 R. 11W

Well No. 4 Soeken "A"

Vickers Company

FIRST REPORT Contractor

SW NE SE

SECTION PLAT

990 Ft. from N. Line

\_\_\_\_\_ Ft. from S. Line

990 Ft. from E. Line

\_\_\_\_\_ Ft. from W. Line


Barton County

Location \_\_\_\_\_

Rig up \_\_\_\_\_

Drilling and Remarks:

R U R

RECORD

Cased \_\_\_\_\_ in., \_\_\_\_\_ ft.

Sand \_\_\_\_\_

Gas \_\_\_\_\_

Oil \_\_\_\_\_

Total Depth \_\_\_\_\_

PRODUCTION

1st 24 hrs. Nat. \_\_\_\_\_

1st 24 hrs. after shot \_\_\_\_\_

Gas \_\_\_\_\_ Cu. Ft.

Dry Hole \_\_\_\_\_

Abandoned \_\_\_\_\_

Date

JAN 28 1948 19

S. J. LEWIS Scout

