


Section 22 Township 17 Range 11-W

Well No. #3 Disque

Company Shell

Krait Prusa Pool

NORTH

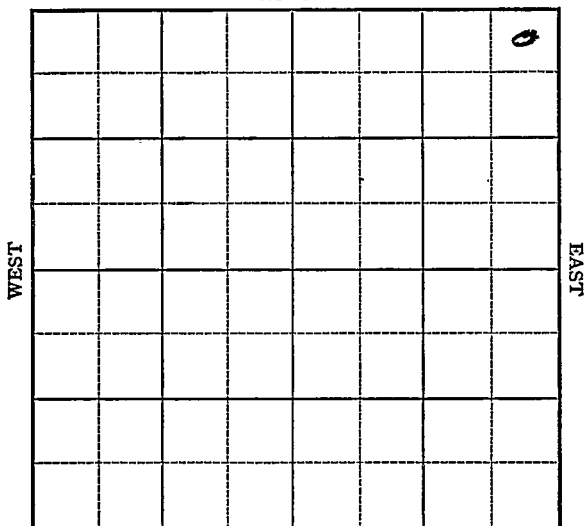

SOUTH

Sec. 22 Twp. 17 R. 11-W

Well No. #3 Disque Farm

Shell Company

(Kraft Prusa Pool)


330 Ft. from N. Line

_____ Ft. from S. Line

330 Ft. from E. Line

_____ Ft. from W. Line

Elev. 1857

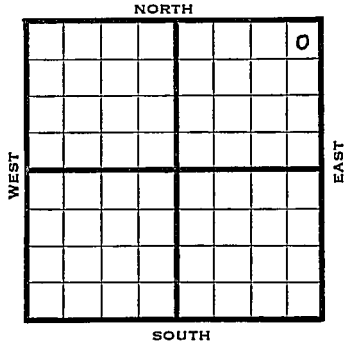

1942

REPORT

8/5 8" 856'
Drlg. 1380'

8/12 Drlg. 2920

8/19 Lans. 3030 Arb. 3303
5" - 3305 T.D. 3307
RUST.

8/27 TD 3320 swb 70 fluid in 6 hrs
cut 95% BS & W PB.

9/2 Arb. 3303
5" - 3305 Water
T.D. 3320'

ABANDONED

Barton

KANSAS

Map No. 55 Sec. 22 Twp. 17 R. 11WWell No. 3 Disque

Shell

Company

FIRST REPORT

Contractor

NE/C

SECTION PLAT

330 Ft. from N. Line

Ft. from S. Line

330 Ft. from E. Line

Ft. from W. Line

			0

KRAFT PRUSA POOL

Location _____

Rig up _____

Drilling and Remarks:

8"-856'

Drlg. 1380'

RECORD

Cased _____ in., _____ ft.

Sand _____

Gas _____

Oil _____

Total Depth _____

PRODUCTION

1st 24 hrs. Nat. _____

1st 24 hrs. after shot _____

Gas: _____ Cu. Ft.

Dry Hole _____

Abandoned _____

Date

AUG 5 1942 19

S. J. LEWIS Scout

Map No. 55 Sec. 22 Twp. 17 R. 11WWell No. 3 Disque _____

Shell _____ Company

ABANDONED Contractor

NE/C

SECTION PLAT

330 Ft. from N. Line

_____ Ft. from S. Line

330 Ft. from E. Line

_____ Ft. from W. Line

			0

KRAFT PRUSA POOL

Location _____

Rig up _____

Drilling and Remarks:

Cor 43303
5' @ 3305'
Water

RECORD

Cased _____ in., _____ ft.

Sand _____

Gas _____

Oil _____

Total Depth 2320

PRODUCTION

1st 24 hrs. Nat. _____

1st 24 hrs. after shot _____

Gas _____ Cu. Ft.

Dry Hole _____

Abandoned _____

Date

SEP 2 1942 19

S. J. LEWIS Scout