


Section 21 Township 17 Range 11-W

Well No. #2 Soeken "B"

Company Shell

Kraft Prusa Pool NORTH

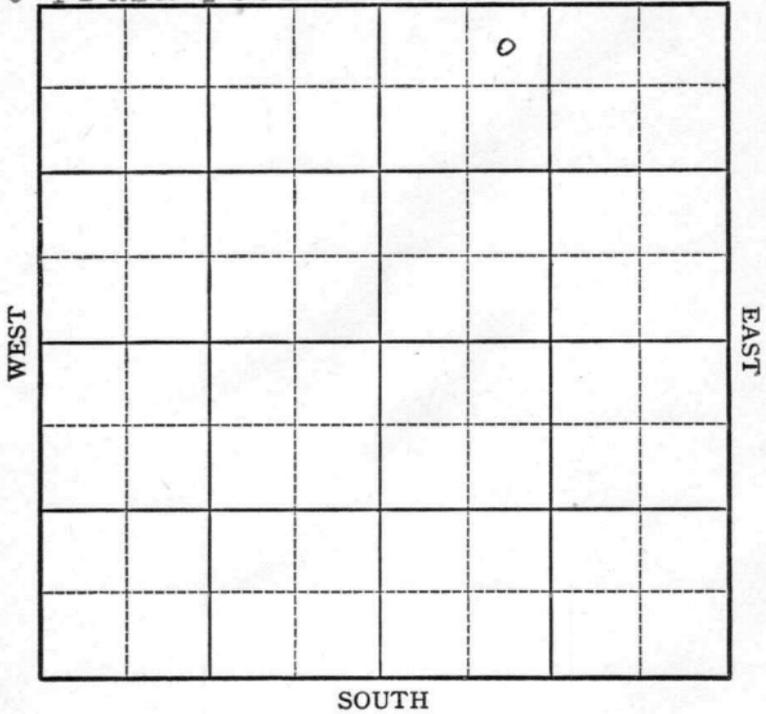

Sec. 21 Twp. 17 R. 11-W

Well No. #2 Soeken "B" Farm _____

Shell Company

(Kraft Prusa Pool)


330 Ft. from N. Line

_____ Ft. from S. Line

_____ Ft. from E. Line

990 Ft. from W. Line

Elev. 1808

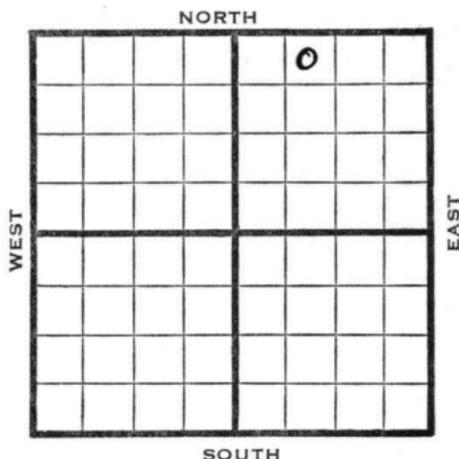

1942

REPORT

8/12	Location	
8/19	8" - 353	
	Drlg. 1065'	
8/27	Topeka 2636	Drlg 2928
9/2	Lans. 2990	Arb. 3288
	T.D. 3415 SD	
9/9	" "	
9/16	" "	
9/23	Arb. 3288	
	5" 3310	
	TD 3415	
	S.W.D.	

ABANDONED

Map No. 55 Sec. 21 Twp. 17 R. 11W

Well No. 2 Soeken "B"

Shell

Company

FIRST REPORT

Contractor

SECTION PLAT

330 NE NW NE
Ft. from N. Line

_____ Ft. from S. Line

_____ Ft. from E. Line

990 Ft. from W. Line

		0	

KRAFT PRUSA POOL

Location X

Rig up _____

Drilling and Remarks:

RECORD

Cased _____ in., _____ ft.

Sand _____

Gas _____

Oil _____

Total Depth _____

PRODUCTION

1st 24 hrs. Nat. _____

1st 24 hrs. after shot _____

Gas _____ Cu. Ft.

Dry Hole _____

Abandoned _____

Date

AUG 12 1942

19

S. J. LEWIS

Scout

KANSAS

Barton

Map No. 55 Sec. 21 Twp. 17 R. 11W

Well No. 2 Soeken "B"

Shell Company

COMPLETED Contractor

NE NW NE

SECTION PLAT

330 Ft. from N. Line

_____ Ft. from S. Line

_____ Ft. from E. Line

990 Ft. from W. Line

		0	

KRAFT PRUSA POOL

RECORD

Location _____

Cased _____ in., _____ ft.

Rig up _____

Sand _____

Drilling and Remarks:

Gas _____

Oil _____

Per 43288

Total Depth 3415

5" @ 3310

PRODUCTION

SWJ

1st 24 hrs. Nat. _____

1st 24 hrs. after shot _____

Gas _____ Cu. Ft.

Dry Hole _____

Abandoned _____

Date

SEP 23 1942 19

S. J. LEWIS Scout