


KANSAS

Barton

Section 21 Township 17 Range 11-W

Well No. #5 Soeken "A"

Company Vickers Pet.

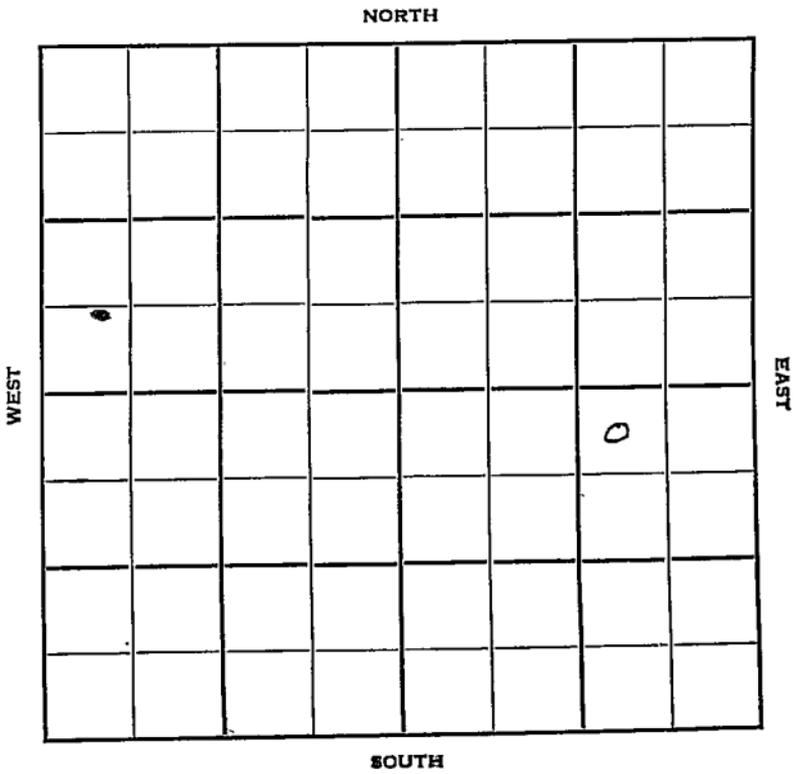

Sec. 21 Twp. 17 R. 11-W

Well No. #5 Soeken "A" Farm

Vickers Pet. Company

Contractor

Kraft-Prusa

330 Ft. from N. Line


Ft. from S. Line

990 Ft. from E. Line

Ft. from W. Line

NW NE SE

Oil Well

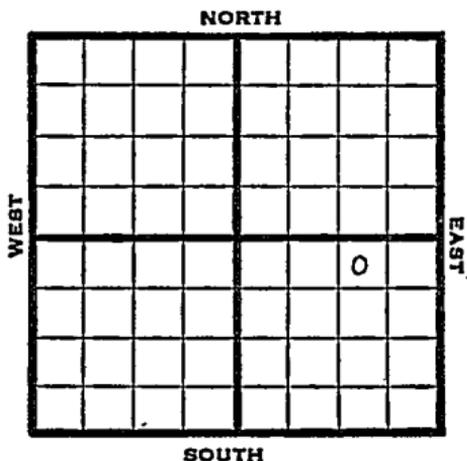

1950

Elev 1824

REPORT

8/2

Location

9/13

Spud 8-4-50

8" @ 325

Heeb 2887

Br line 2995

Lans 3081

Arb 3268

5" @ 3269

TD 3270

FU 1600' oil 400' water 15 hr

S/4 bo 1 bwph 500A

Comp 120 bopd 44% water

TD 3270

Completed

COMPLETED

ans

Map No. _____ Sec. 21 Twp. 17 R. 11W

Well No. 5 Soeken "A"

Vickers Pet. Company

Contractor

NW NE SE

330 Ft. from N. Line

_____ Ft. from S. Line

990 Ft. from E. Line

_____ Ft. from W. Line

SECTION PLAT

FIRST REPORT

Barton County

Location X

Rig up _____

Drilling and Remarks:

RECORD

Cased _____ in., _____ ft.

Sand _____

Gas _____

Oil _____

Total Depth _____

PRODUCTION

1st 24 hrs. Nat. _____

1st 24 hrs. after shot _____

Gas _____ Cu. Ft.

Dry Hole _____

Abandoned _____

Date

AUG. 2 1950

J. E. TYRA

Scout

