


Section 22 Township 17 Range 11-W

Well No. #2 Disque

Company Shell
Kraft Prusa Pool

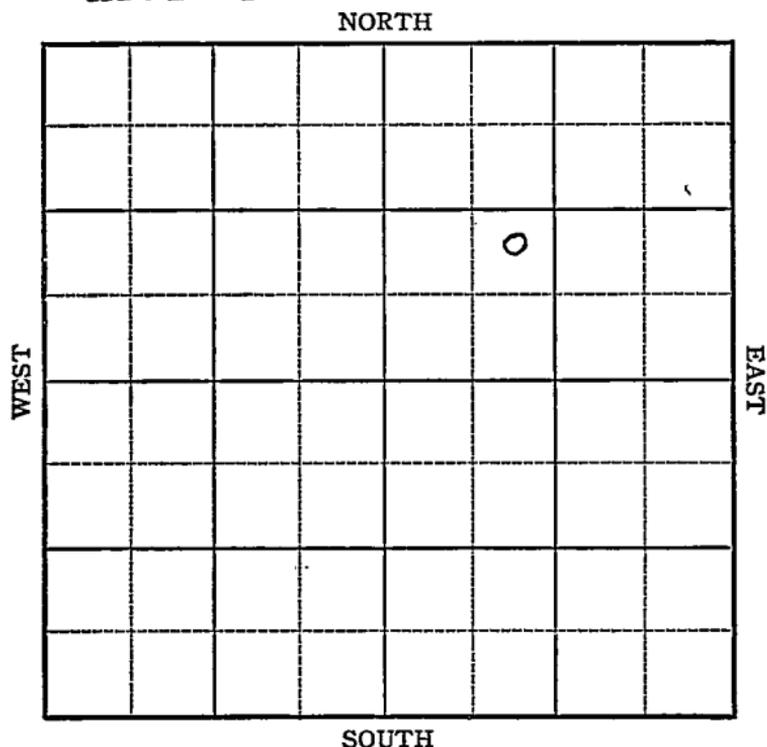

Sec. 22 Twp. 17 R. 11-W

Well No. #2 Disque Farm

Shell Company


(Kraft Prusa Pool)

_____ Ft. from N. Line

990 Ft. from S. Line

_____ Ft. from E. Line

990 Ft. from W. Line

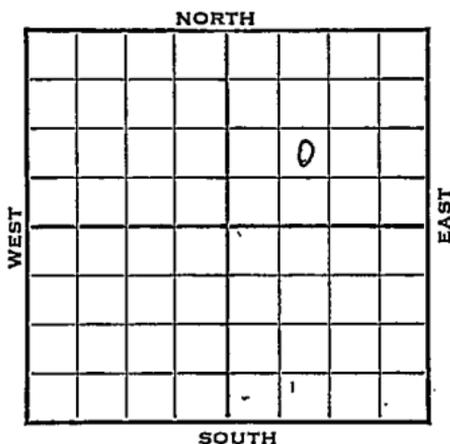

Elev. 1847

1942

REPORT

7/29

8" - 343'
Drlg. 1235'

8/5

Drlg. 3126'

8/12

Arb 3269 4" @ 3270-79
TD 2800 oil' 11½ hrs.

8/19

Arb. 3269 4" - 3270
TD 3287 3000 acid
Depth Pot. 3020
Max 3000
Gravity 43.6

COMPLETED

Map No. 55 Sec. 22 Twp. 17 R. 11W

Well No. 2 Disque

Shell Company

COMPLETED Contractor

NE SW NE

SECTION PLAT

_____ Ft. from N. Line

990 Ft. from S. Line

_____ Ft. from E. Line

990 Ft. from W. Line

		o	

KRAFT PRUSA POOL

Location _____

Rig up _____

Drilling and Remarks:

*Cor 43269
4" @ 3270
3000 acid
Depth Port. 3020
Max 3000
436 Gr*

RECORD

Cased _____ in., _____ ft.

Sand _____

Gas _____

Oil _____

Total Depth 3287

PRODUCTION

1st 24 hrs. Nat. _____

1st 24 hrs. after shot _____

Gas _____ Cu. Ft.

Dry Hole _____

Abandoned _____

Date

AUG 1 9 1942 19

S. J. LEWIS Scout