


Section 22 Township 17 Range 11-W

Well No. #3 Soeken

Company Stanolind

NORTH Kraft Prusa Pool

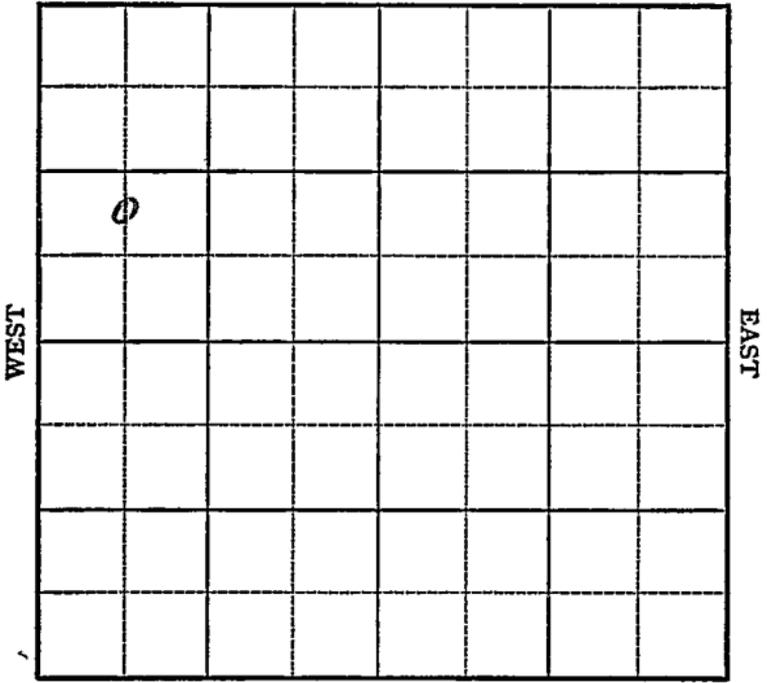

SOUTH

Map No. 55 Sec. 22 Twp. 17 R. 11WWell No. 3 SoekenStanolind

Company

FIRST REPORT

Contractor

C NL SW NW

SECTION PLAT

o			

_____ Ft. from N. Line

990 Ft. from S. Line

_____ Ft. from E. Line

660 Ft. from W. Line**KRAFT PRUSA POOL**

Location _____

Rig up _____

Drilling and Remarks:

Rotary

RECORD

Cased _____ in., _____ ft.

Sand _____

Gas _____

Oil _____

Total Depth _____

PRODUCTION

1st 24 hrs. Nat. _____

1st 24 hrs. after shot _____

Gas _____ Cu. Ft.

Dry Hole _____

Abandoned _____

Date

APR 15 1942

19

S. J. LEWIS

Scout

