

KANSAS

Barton

FORM 51 5M 10-41 PETROL


Section 22 Township 17 Range 11-W

Well No. #4 Disque

Company Shell

Kraft Prusa Pool

NORTH

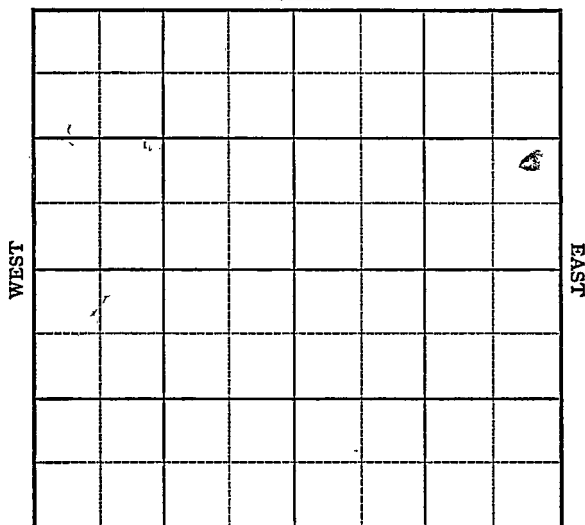

SOUTH

KANSAS Barton

Sec. 22 Twp. 17 R. 11-W

Well No. #4 Disque Farm

Shell Company


(Kraft Prusa Pool)

 Ft. from N. Line

990 Ft. from S. Line

330 Ft. from E. Line

 Ft. from W. Line

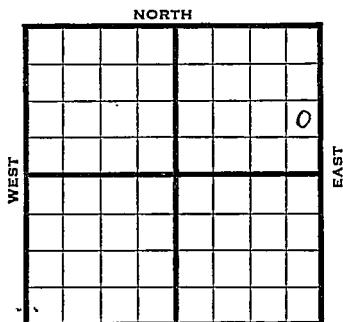

Elev. 1849

1942

REPORT

9/9

8" - 352' Drlg. 2155'

9/16

Topeka 2660 Lans 3004
Arb 3275-77 TD Run 4"

9/23

4 1/2" @ 3276 Drlg 3283

9/30

Topeka 2660
Lansing 3004
Arb. 3275
4 1/2" 3276
TD 3294
2000 acid
Deptho. pot. 1350 bopd
Plus 40 bwpd
43.6 grav.

COMPLETED

Barton

KANSAS

Map No. 55 Sec. 22 Twp. 17 R. 11WWell No. 4 DisqueShell

Company

FIRST REPORT

Contractor

NE SE NE

 Ft. from N. Line990 Ft. from S. Line330 Ft. from E. Line Ft. from W. Line

SECTION PLAT

KRAFT PRUSA POOL

Location Rig up

Drilling and Remarks:

8"-352'

Dr1g. 2155'

RECORD

Cased in., ft.Sand Gas Oil Total Depth

PRODUCTION.

1st 24 hrs. Nat. 1st 24 hrs. after shot Gas Cu. Ft.Dry Hole Abandoned

Date

SEP 9 1942 19

S. J. LEWIS Scout

KANSAS

Map No. 35 Sec. 22 Twp. 17 R. 11WWell No. 4 DisqueShell

Company

Contractor

NE SE NE

SECTION PLAT

 Ft. from N. Line990 Ft. from S. Line330 Ft. from E. Line Ft. from W. Line

			6

KRAFT PRUSA POOL

Location Rig up

Drilling and Remarks:

2000 Acid
 Depth. Pot.
 1350 Bopd
 Plus 40 Bwpd
 43.6 grav
 V

RECORD

Cased 4 1/2 in., 3276 ft.Sand Gas Oil Total Depth 3294

PRODUCTION

1st 24 hrs. Nat. 1st 24 hrs. after shot Gas Cu. Ft.Dry Hole Abandoned

Date

COMPLETED

SEP 30 1942 19

S. J. LEWIS Scout

Topoka 2660
Lansing 3004
Arb 3275

Misc. Small Maps

Cards

Tracing

France Map

Scarborough Map

Moody Map

Geological Dept.

Moody Flat Book