


FORM 51 5M PETROL

Section 22 Township 17 Range 11W

Well No. 4 Heller

Company Skelly

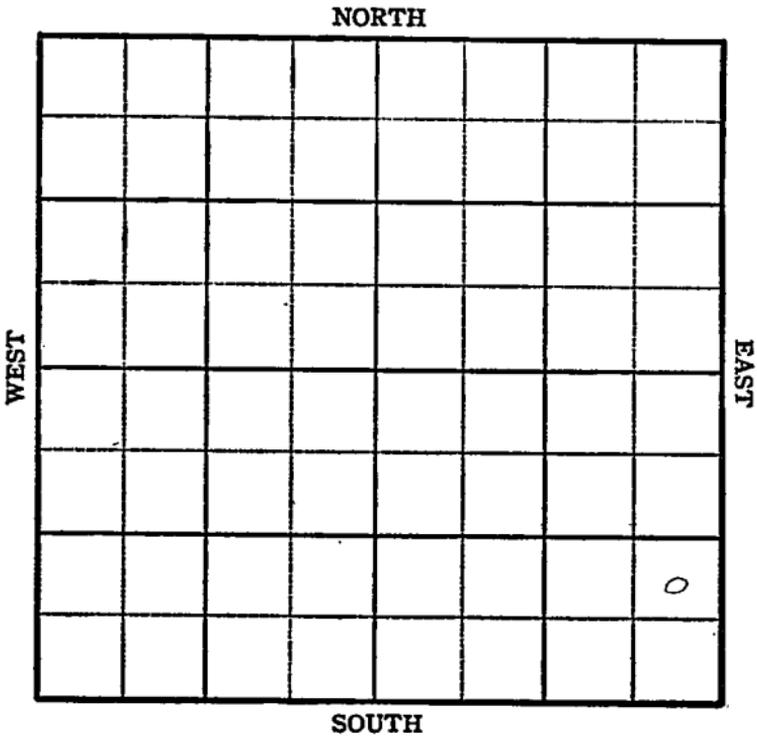

Sec. 22 Twp. 17 R. 11-W

Well No. #4 Heller Farm


Skelly Company

         Ft. from N. Line

990 Ft. from S. Line

330 Ft. from E. Line

         Ft. from W. Line

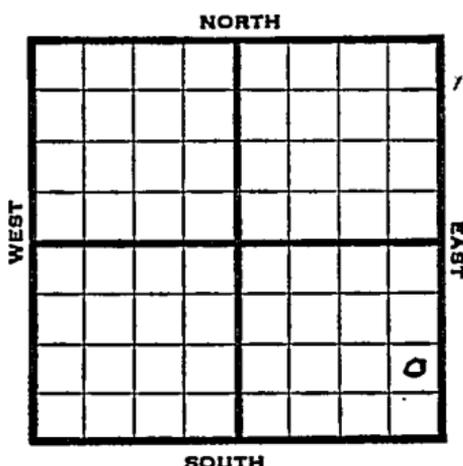

NE SE SE

1945 Elev. 1846 REPORT

10/10 RUR

10/17 8" @ 345

Drlg. 1049'

10/24 Lans 3017

Arb. 3297-3298

TD 3298

5" @ 3298 RUST

" " " "

10/31

11/7 Arb. 3297

5" @ 3298

500 acid.

TD 3309'

Pump 75 oil plus 24 W. Pot.

Grav. 42.0

COMPLETED



