

KANSAS


FORM 51 5M 6-46 PETROL

Barton county

Section 22 Township 17 Range 11-W

Well No. #4, Soeken

Company Biddle Drilg.

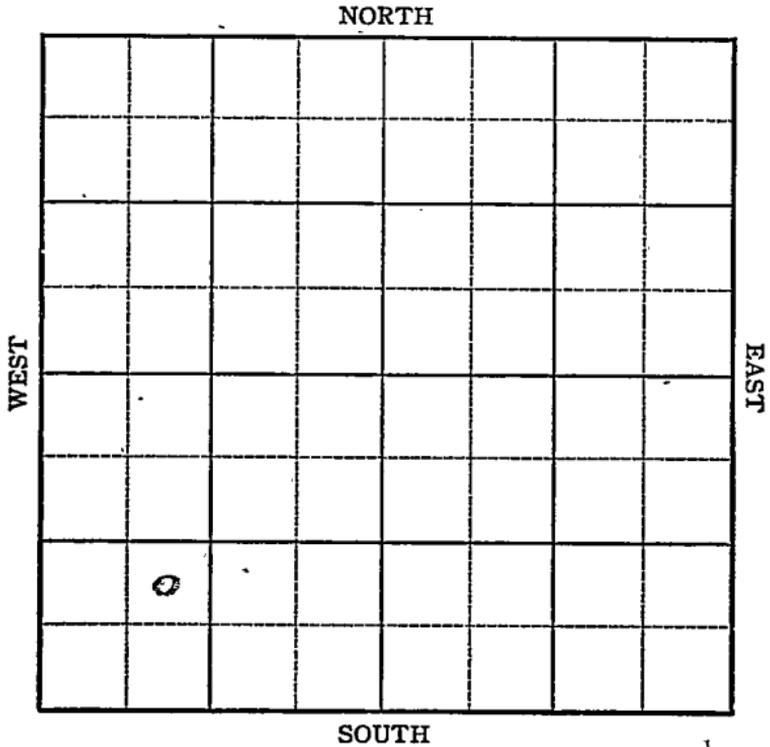

KANSAS

Barton county ✓

Sec. 22 Twp. 17 R. 11-W

Well No. #4, Soeken Farm

Biddle Drlg. Company  
Kraft-Prusa


\_\_\_\_\_ Ft. from N. Line

990' Ft. from S. Line

\_\_\_\_\_ Ft. from E. Line

990' Ft. from W. Line

NE SW SW

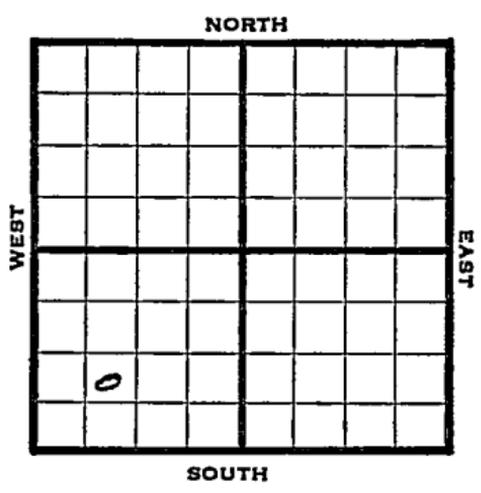

1946 Elev. 1827' REPORT

10/30 8" @ 200'  
WOC

11/6 Drlg 2632'

11/12 Land 3035'  
Arb 3276-78 TD  
5" @ 3276, RUST

11/20 TD 3300'  
PB 3157'  
48 shots 3146-57, 3000 acid  
swb 5 oil PH

11/27 " " " "

12/3 " " " "

12/11 Arb 3276'  
5" @ 3276'  
TD 3300'  
Lans 3035'  
Perf Lans  
3000 Acid  
Pump 305 POT  
42 Grav.

**COMPLETED**



