

Section 22 Township 17 Range 11WWell No. #6 DisqueCompany Shell Oil

NORTH

				0			

WEST

EAST

SOUTH

Barton

Sec. 22 Twp. 17 R. 11W

Well No. #6 Disque Farm

Shell Oil

Company

B & R Contr

Contractor

Kraft Prusa


990' Ft. from N. Line

_____ Ft. from S. Line

_____ Ft. from E. Line

330' Ft. from W. Line

SW NW NE

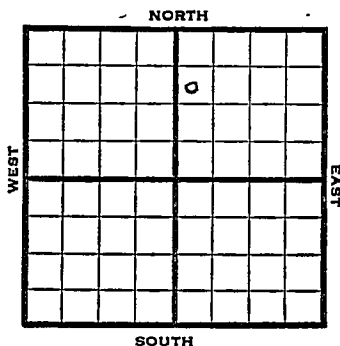

1952

Elev. 1839' REPORT

1/23

Spud 1-15-52

10" @ 380

Drlg. 2578'

2/6

TD 3334

7" @ 3333, tstg.

2/13

No report

2/20

"

3/5

"

3/12

Spud 1-15-52

Oil Well TD 3334

10" @ 380 Lans. 3004

Arb. 3266 TD 3334

7" @ 3333 CO to 3295

24/3266-72 7 bo 9 bw 4 hrs.

500 A 111 bo 115 bw 5 hrs.

Comp. 752 bopd

COMPLETED

County Barton State Kansas

Sec. 22 (Blk. Twp.) 17 (Sur. Rge.) 11W Map No.

Operator **Shell Oil**

Well No. **6** Farm **Disque**

Elev. Location SW NW NE

990 Ft. From N Line NE

330 Ft. From W Line Quarter

1st. Report **JAN 23 1952**

Completion

Remarks

B & R - Contr.

Spudding Date **1-15-52**

Drlg. Data Kraft Prusa

10" @ 380 Drlg. 2578


J. E. TYRA

County Barton State
 Sec. 22 (Blk. 17 (Sur. 11W Map No.
 (Twp.) (Rge.)

Operator Shell Oil

Well No. 6 Farm Disque

Elev. 1839 Location SW NW NE

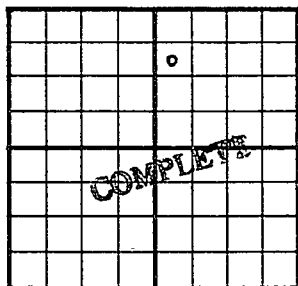

990 Ft. From N Line NE

330 Ft. From W Line Quarter

1st. Report

Completion MAR 12 1952

Remarks Kraft-Prusa Pool
B & R Drlg. - Contr.

Spudding Date 1-15-52

Drlg. Data Oil well TD 3334

10" @ 380 Lans. 3004 Arb. 3266

TD 3334 7" @ 3333 CO to 3295

24/ 3266-72 7 bo 9 bw 4 hr. 500 A

111 bo 115 bw 5 hr.

Comp. 752 bopd