

O. W. P. B.


Barton county

FORM 51 IOM 12-46 **KANSAS**

Section 22' Township 17 Range 11-W

Well No. #5, Heller

Company Skelly Oil Company

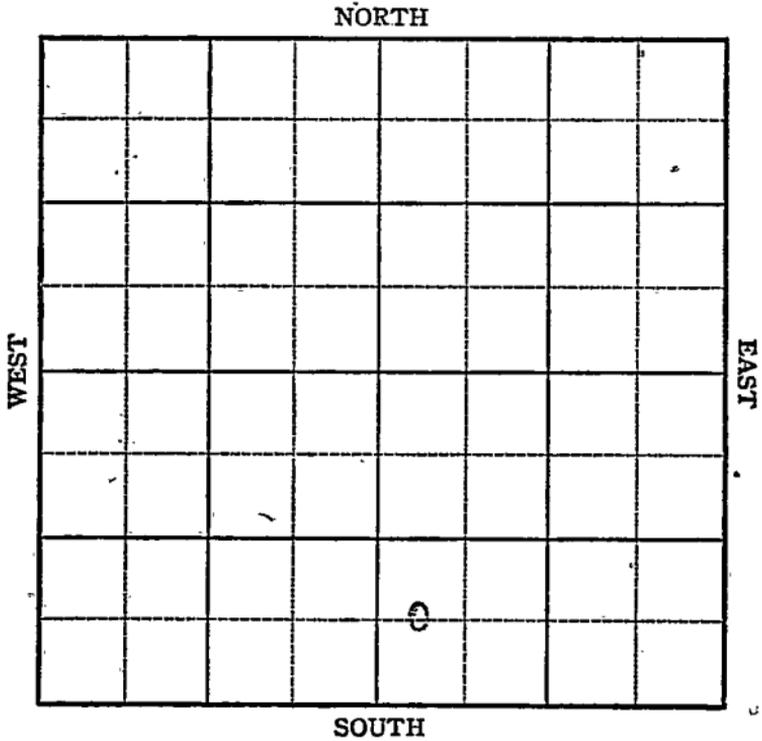

Sec. 22 Twp. 17 R. 11-W

Well No. #5, Heller Farm

Skelly Oil Company Company


Kraft-Pruse

 Ft. from N. Line

660' Ft. from S. Line

 Ft. from E. Line

330' Ft. from W. Line

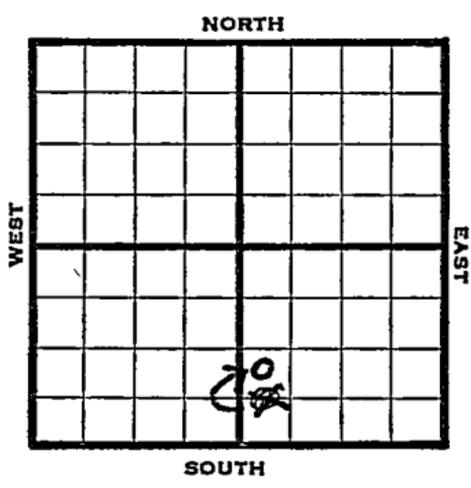

NW
C W L SW SE

1946 **REPORT**

Elev. 1838

12/4 Location

12/10 "

12/17 8" @ 406'
Drlg 1420'

1947

1/4 Lans 3008'
Arb 3276'
TD 3295'
500 acid, swb 5 oil PH

1/8 1500 acid
Swb 50 oil in 4 hrs.

1/15 Arb 3276'
5" @ 3276 1/2'
TD 3296'
2000 Acid
Pump 319 Pot
42-GR

COMPLETED

1956 **W. P. B.**
1/18 OTD 3295'

L. 3007'. A. 3267'. TD 3295'
5" @ 3268 PB 3240 24/3218-26
500 A PB 3195 24/3179-87 1500 A
B/15 GO 76 GAW 3 hr. PB 3161
50/3114-52 3000 A S/41 BO 7 BW
10 hr. PB 3088 36/3060-66 500 A
S/10 GAWPH 4 hr. 49/3066-74
1000# S/22 GAWPH 6 hr. PB 3043'
48/3024-33 500 A S/12 BW 6 hr.

1956
1/18

(Information continued)
Sq. perf 3024-33. DP 3240
P/40 BO 34 BWP. Comp.
TD 3295'

**FIRST REPORT
COMPLETED**

Kansas

Map No. 55 Sec. 22 Twp. 17 R. 11W

Well No. 5 Heller

Skelly Company

FIRST REPORT

Contractor

C W L SW SE

SECTION PLAT

 Ft. from N. Line

660 Ft. from S. Line

 Ft. from E. Line

330 Ft. from W. Line

		0	

Barton County

Location X

Rig up

Drilling and Remarks:

RECORD

Cased in., ft.

Sand

Gas

Oil

Total Depth

PRODUCTION

1st 24 hrs. Nat.

1st 24 hrs. after shot

Gas Cu. Ft.

Dry Hole

Abandoned

Date

DEC 4 1946

19

S. J. LEWIS

Scout

Map No. 55 Sec. 22 Twp. 17 R. 11W

Well No. 5 Heller

Skelly Company

COMPLETE

Contractor

C W L SW SE

E. 1838.

SECTION PLAT

		0	

_____ Ft. from N. Line

660 Ft. from S. Line

_____ Ft. from E. Line

330 Ft. from W. Line

Barton County

Location _____

Rig up _____

Drilling and Remarks:

✓ Cr 3276
5" @ 3276 1/2
2000 acid
Prod 319 BT
42 2 Gr

RECORD

Cased _____ in., _____ ft.

Sand _____

Gas _____

Oil _____

Total Depth 3295

PRODUCTION

1st 24 hrs. Nat. _____

1st 24 hrs. after shot _____

Gas _____ Cu. Ft.

Dry Hole _____

Abandoned _____

Date

JAN 15 1947 19

S. I. LEWIS Scout

O. W. P. B.

FORM 513 REV. SUNRAY

OWPB

County	Barton	Elev.	1838
Sec.	22	Twp.	17
		Rge.	11W
Company	Skelly Oil		
Farm Name	A. Heller		No. 5

TOPS	DEPTH	LOG	DATUM	Loc. in Sec.
Anh.				NW SW SE
Tp.				
H.				
Tr.				
Dg.				
Bl.	3007			Geol.
L.				Contr.
K.C.				
B.K.C.				
Ce.				
C.				
M.				
M.				
K.				
Mz.				
Me.				
V.				
S.				
S.	3267			
A.				
R.				
Pe.				
G.				
T.D.	3295			

~~Blower~~
~~Krait Prusa~~

JAN 18 56

FIRST REPORT COMPLETE

Date Comm.

OTD 3295 5" @ 3268 PB 3240 24/ 3218-

26 500 A PB 3195 24/ 3179-87

1500 A B/ 15 go 76 gaw 3 hr.

PB 3161 50/ 3144-52 3000 A

S/ 11 bo 7 bw 10 hr. PB 3088

36/ 3060-66 500 A S/ 10 gawph 4 hr.

49/ 3066-74 1000 A S/ 22 gwph 6 hr.

PB 3043 48/ 3024-33 500 A S/ 12 bw

6 hr. sq. perf. 3024-33 DP 3240

P/40 bo 34 bwpd Comp.

M. M.

JAN 26 1950