


Section 22 Township 17 Range 11W

Well No. #7 H. Disque

Company Shell

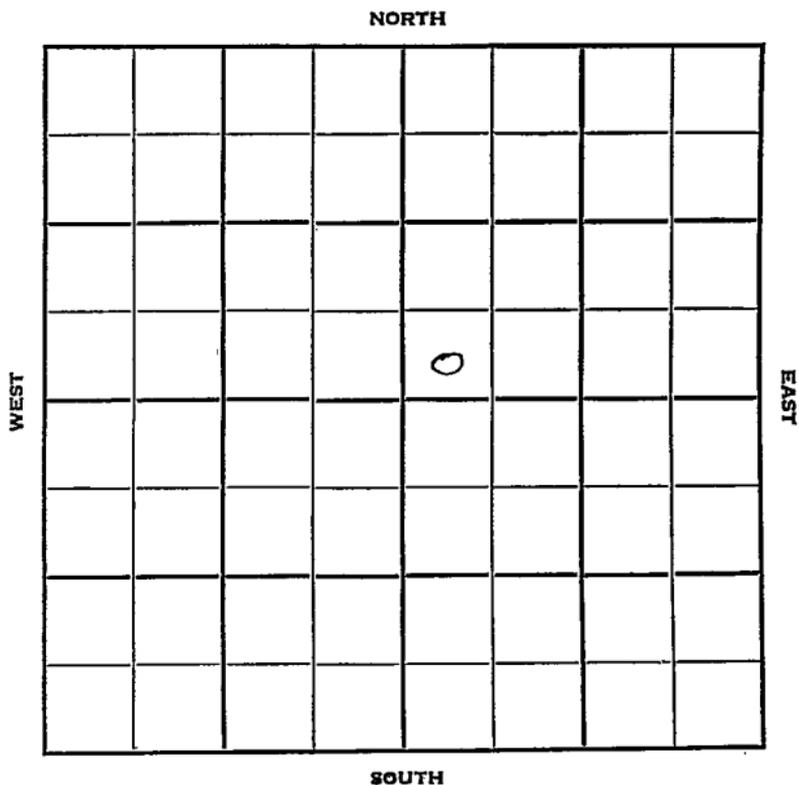

Sec. 22 Twp. 17 R. 11 W

Well No. # 7 H. Disque Farm

Shell Company

B & R Contractor


_____ Ft. from N. Line

330 _____ Ft. from S. Line

_____ Ft. from E. Line

330 _____ Ft. from W. Line

SW SW NE

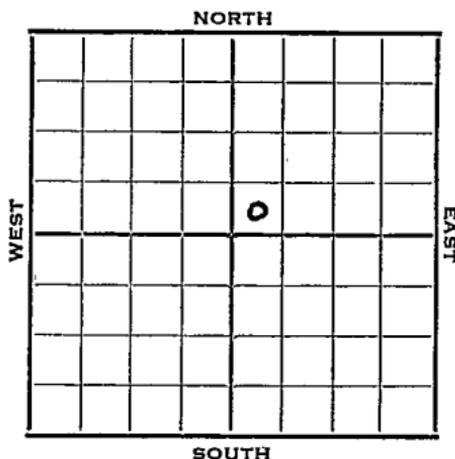

| 1952 | Elev. 1839' REPORT |
|------|--|
| 3/26 | Spud 3-24-52 Drilling 300' |
| 4/1 | 10" @ 380' Drlg. 2600' |
| 4/9 | Lans. 3004 Arb. 3267-3332 RTD DO 7" @ 3331 |
| 4/23 | CO to 3306' 20/3286-96 S/128 BW 3 hrs. PB 3283' 28/3265-72 B/1 gal O plus trace water. 250 A Re-perf 28/3265-72 36/3272-74 S/38 BW plus trace oil PH for 5 hrs. To sq. off. |
| 4/30 | Sq. off 3265-74 CO 37/3256-65 37/ 3265-74 250 A B/ 18 BO & 1 BW 21 hrs. 500 A S/ 15 boph for 2 hrs. 70% wtr. |
| 5/7 | S/16 BF 1 hr. 80% wtr. POP |
| 5/14 | NR |
| 5/21 | " |
| 5/28 | " |

OVER

1952

6/11

Spud 3-24-52

Oil Well TD 3332

10" @ 380

Lans. 3004 Arb. 3267

TD 3332 7" @ 3331

CO to 3306

20/3286-91 S/128 bw 3 hr.

PB 3283 28/3265-72

B/1 go tr. wtr ph

250 A 28/3265-72 36/3272-74

S/38 bw tr. oil ph

37/3256-65 37/3265-74 250 A

B/18 bo 1 bw 21 hr.

500 A S/15 bfph 70% wtr.

S/16 bf 1 hr. 80% wtr

Comp. 46 bopd 204 bw

COMPLETED

