


KANSAS

Section 22 Township 17 Range 11W

Well No. #7 Heller

Company Skelly
Kraft-Prusa

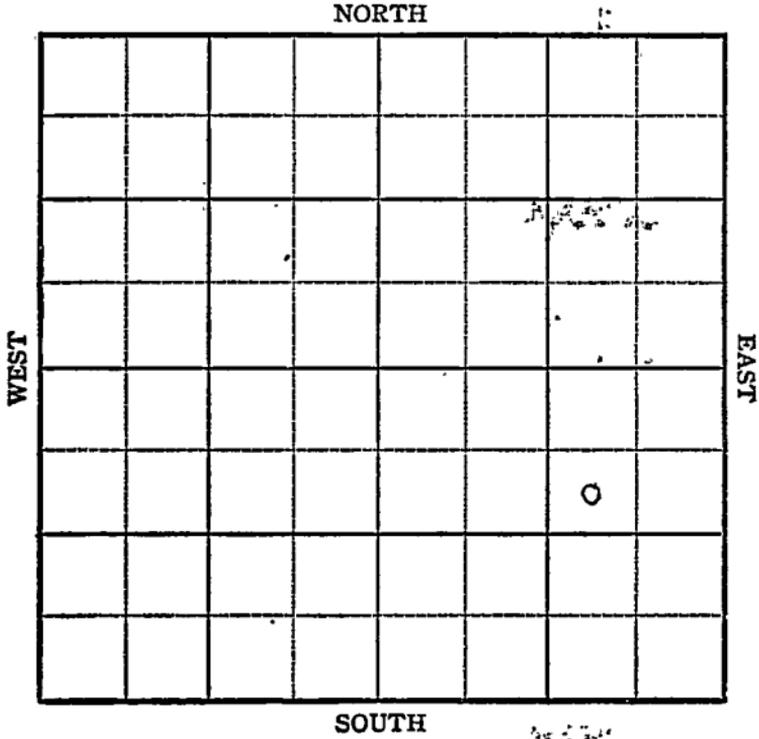

Sec. 22 Twp. 17 R. 11-W

Well No. #7 Heller Farm


Skelly Company
Kraft-Prusa

990 Ft. from N. Line

_____ Ft. from S. Line

990 Ft. from E. Line

_____ Ft. from W. Line

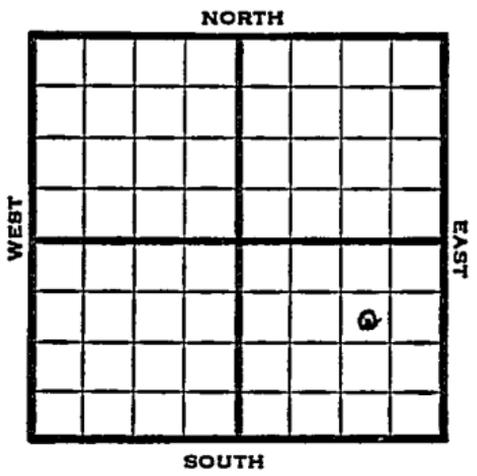

SW NE SE

1948	Edi 3285' ^{REPORT} <i>wrong over.</i>
10/13	Location
10/19	8" @ 630' Drlg 2150'
10/26	Lansing 2980' Arb. 3268-71' TD 3271' 5" @ 3269'
11/3	TD 3285' 500 acid swb 38 bbls oil - 4 hrs.
11/10	TD 3285' Arb. 3268' 5" @ 3269' 500 acid Pump 347 Oil Pot 42° gr. Comp
	COMPLETED

Map No. _____ Sec. 22 Twp. 17 R. 11W

Well No. 7 Heller

Skelly Company

FIRST REPORT

Contractor

SW NE SE

SECTION PLAT

990 Ft. from N. Line

_____ Ft. from S. Line

990 Ft. from E. Line

_____ Ft. from W. Line

			o

Barton County

Location X

Rig up _____

Drilling and Remarks:

RECORD

Cased _____ in., _____ ft.

Sand _____

Gas _____

Oil _____

Total Depth _____

PRODUCTION

1st 24 hrs. Nat. _____

1st 24 hrs. after shot _____

Gas _____ Cu. Ft.

Dry Hole _____

Abandoned _____

Date

OCT 13 1948 19

S. J. LEWIS Scout

