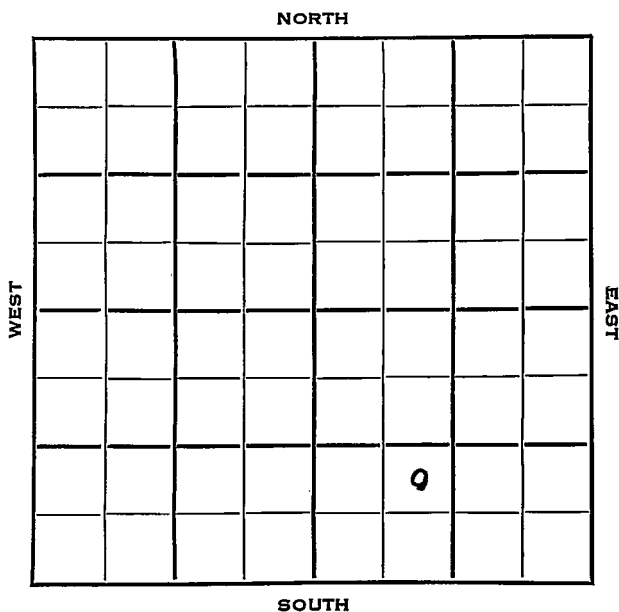


Section 4 Township 18 Range 8 WWell No. # 2 HawkinsCompany Dozier Oil

Rice KANSAS ✓

Sec. 4 Twp. 18 R. 8WWell No. #2 Hawkins FarmDozier Oil CompanyStagg Drlg. Contractor
Geneseo Pool


Ft. from N. Line

990 Ft. from S. Line

Ft. from E. Line

990 Ft. from W. Line

NE SW SE

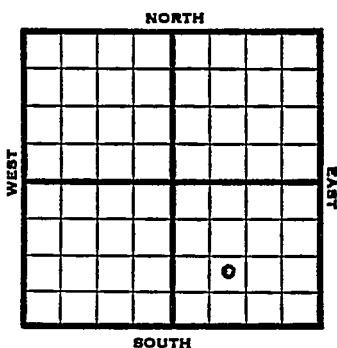

1953 Elev. 1754' REPORT

5/13 MIR

5/21 8" @ 220 Anhy 355
Drlg. 1700'5/28 Heeb 2690, Br L. 2809, Lans 2831, Cong
3182, Arb 3202
RTD 3211
5" @ 3204'6/3 CO 3211 4 boph 2700' OB DD 2218
TD 4 boph POP

6/10 N.R.

6/17 Spud 5-11-53

Oil Well

TD 3218'

8" @ 220'

Anhy 355, Heeb 2690, Br. Lime 2809,
Lans 2831, Cong 3182, Arb 3202

TD 3211'

5" @ 3204'

CO to 3211

4 boph

DST 3183-3200 opn 1 hr, rec 30' o & gcm

240' oily mcw 750#

Comp. 1644 bopd 1% wtr.

COMPLETED

County **Rice** State **Kansas**

Sec. 4 (Blk. 18 (Sur. 8W Map No. _____
(Twp. 18 Rge. _____)

Operator Dozier Oil

Well No. **2** Farm **Hawkins**

Elev.	Location	NE	SW	SE
-------	----------	----	----	----

FIRST REPORT

990 Ft. From S Line SE

990 Ft. From V Line Quarter

1st. Report MAY 13 1953

Completion


Remarks

Stagg Drlg. - Contr.

Spudding Date _____

Drig. Data Geneseo Pool

M I R

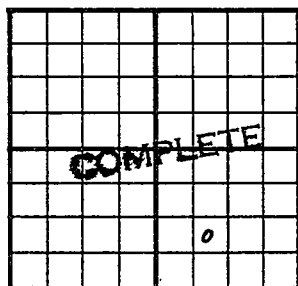County Rice State KansasSec. 4 (Blk.) 18 (Sur.) 8W Map No.
(Twp.) (Rge.)Operator Dozier OilWell No. 2 Farm HawkinsElev. 1754 Location NE SW SE990 Ft. From S Line SE990 Ft. From W Line Quarter1st. Report Completion JUN 17 1953Remarks Geneseo PoolStag Drlg. - Contr.Spudding Date 5-11-53Drlg. Data Oil well TD 32188" @ 220 Anhy 355 Heeb. 2690Br. line 2809 Lans. 2831 Cong. 3182Arb. 3 202 TD 3211 5" @ 3 204 CO to 3 2114 boph DST 3183-3200 open 1 hr.Rec. 30' o & gcm 240' oily mcw 750#Comp. 1644 bopd 1% wtr.

J. G. McGEHEE