




Rice

KANSAS

Sec. 4 Twp. 18 R. 8W

Well No. #1 Hawkins Farm  
J. C. Dozier Company  
Stagg Drlg. -Contr. Contractor

\_\_\_\_\_ Ft. from N. Line  
330' Ft. from S. Line  
 \_\_\_\_\_ Ft. from E. Line  
990' Ft. from W. Line

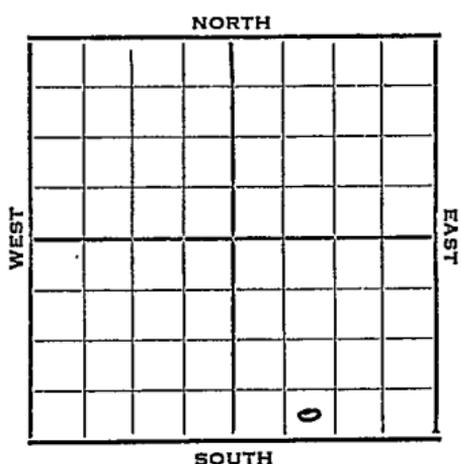

SE SW SE


1951 Elev. 1753' REPORT

12/12 Set surface  
 1952  
 1/30 Spud 12-13-51  
 Oil Well TD 3267  
 8" @ 204  
 Heeb. 2689 Br. Li 2811  
 Lans. 2832 Arb. 3252559  
 5" @ 3252 DD 3261 20/ 3253-59  
 500 A S/ 1 1/2 boph 1000 A S/ 3 boph  
 DD 3267 S/ 5 boph  
 Comp. 75 bopd 4% wtr.

**COMPLETED**



County Rice State Kansas  
 Sec. 4 (Blk. 18) (Sur. 8W) Map No. \_\_\_\_\_  
 Operator J. C. Dozier  
 Well No. 1 Farm Hawkins  
 Elev. 1753 Location SE SW SE

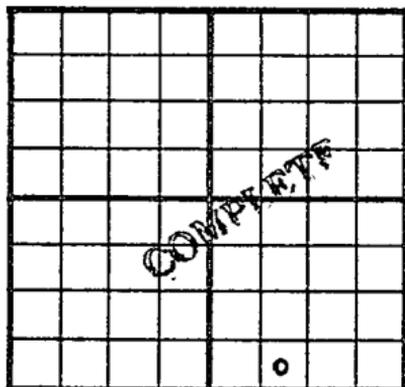

330 Ft. From S Line SE  
990 Ft. From W Line Quarter  
 Ist. Report \_\_\_\_\_  
 Completion JAN 30 1952  
 Remarks \_\_\_\_\_  
Stagg Drlg. - Contr.  
 Spudding Date 12-13-51

Drlg. Data Oil well TD 3267  
8" @ 204 Heeb. 2689 Br. lime 2811  
Lans. 2832 Arb. 3252-59 5" @ 3252  
DD 3261 20/ 3253-59 500 A  
S/ 1½ boph 1000 A S/ 3 boph  
DD 3267 S/ 5 boph Comp. 75 bopd 4%w