
FORM 51

Rice KANSAS

Section 4 Township 18 Range 8 W

Well No. # 1 Hawkins "B"

Company Dozier Oil

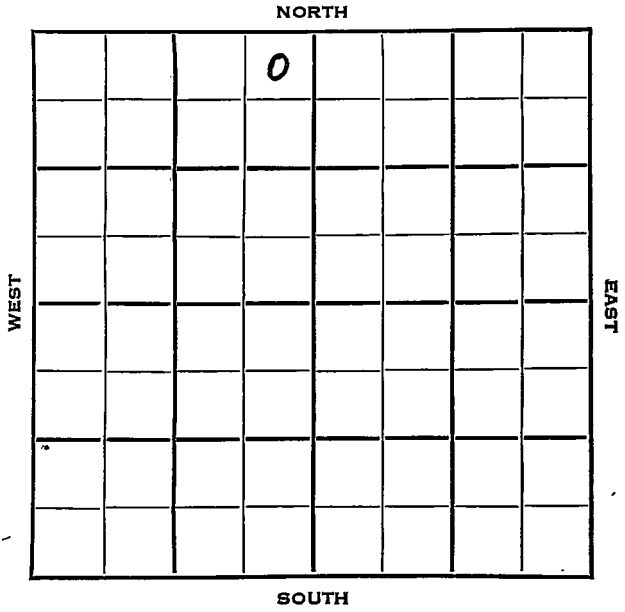

Rice KANSAS

SEC.	TWP.	R.
4	18	8W

WELL NO.

#1 Hawkins "B" FARM

COMPANY

Dozier Oil

CONTRACTOR

Dozier

Edwards Pool


330 Ft. from N. Line

_____ Ft. from S. Line

330 Ft. from E. Line

_____ Ft. from W. Line

NE NE NW

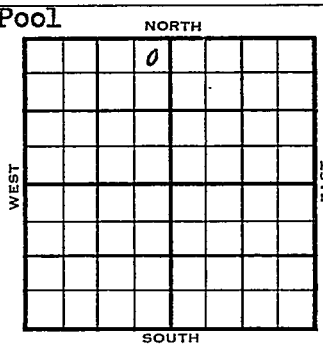

1953	ELEVATION 1766'	REPORT
10/14	Cellar & Pits	
10/21	8" @ 210 Drlg. 2500'	
10/28	Spud 10-15-53 D & A TD 3290' 8" @ 210 Heeb 2721 Br lime 2839 Lans 2863' Cong. 3242' Kh. 3257' TD 3290' D & A **ABANDONED**	

DX-78

FORM 275 FOR SALE BY KANSAS BLUE PRINT CO.


County Rice State Kansas

Sec. 4 (Blk. Twp.) 18 (Sur. Rge.) 8W Map No.

Operator Dozier Oil

Well No. 1 Farm Hawkins

Elev. Location NE NE NW

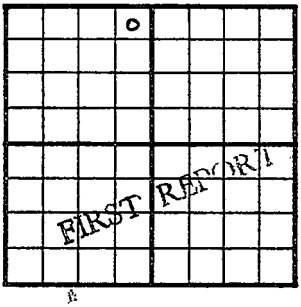

330 Ft. From N Line NW

330 Ft. From E Line Quarter

1st. Report OCT 14 1953

Completion

Remarks

Dozier - Contr.

Spudding Date

Drlg. Data Edwards Pool

Cellar & pits

J. G. McGEHEE

FORM 275 FOR SALE BY KANSAS BLUE PRINT CO.


County Rice State Kansas

Sec. 4 (Blk. Twp.) 18 (Sur. Rge.) 8W Map No.

Operator Dozier Oil

Well No. 1 Farm Hawkins "B"

Elev. 1766 Location NE NE NW

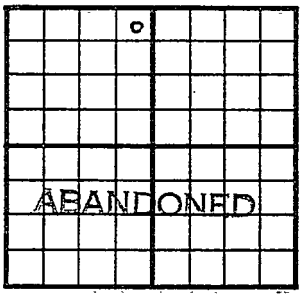

330 Ft. From N Line NW

330 Ft. From E Line Quarter

1st. Report

Completion OCT 28 1953

Remarks Edwards Pool

Dozier - Contr.

Spudding Date 10-15-53

Drlg. Data D & A TD 3290

8" @ 210 Heeb. 2721 Br. lime 2839

Lans. 2863 Cong. 3242 Kh. 3257

TD 3290

D & A

J. G. McGEHEE