


State **Kansas** County **Riley**
 Company **Wm. H. Pine** Well No. **1**
 Farm **Sinn**
 Survey
 Block No. Sec. **25** Twp. **9 S** Range **4 E**
 Co-Ord. Elev. **1252.5 K/B**
1250 Gr.

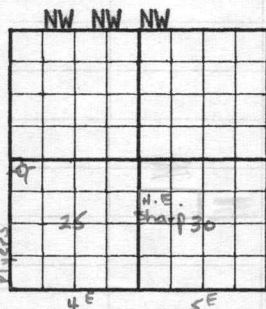

Acreage Contribution:
M-R Oil Co. - 100%

Fred Glassco Deal
Fred Watson, Geol.-Jayhawk
Hotel, Junction City, Ks.

2200' Miss. test to be comm.
by 6-3-58 & comp. by 6-15-58
(rosary)

NOTE: Show Sketch of Lease and Well Location in Above Space

330

Ft. from N. Line

Ft. from S. Line

330

Ft. from W. Line

Ft. from E. Line

Date

Depth

5-28-58

To begin operations

6-1

Set 8-5/8" @ 200' w/75 sx. cer

6-2

SUS

6-3

1100

Drlg.

1425

Lansing (-175)

1495

Kansas City (-245)

6-6

1700

Drlg. (12'/hr.)

(41' low to ϕ in Sec. 14

22' low to ϕ in Sec. 33)

[illegible]