


Rice

KANSAS

Section 4 Township 18 Range 8 W

Well No. # 2 Kratzer

Company Dozier Oil

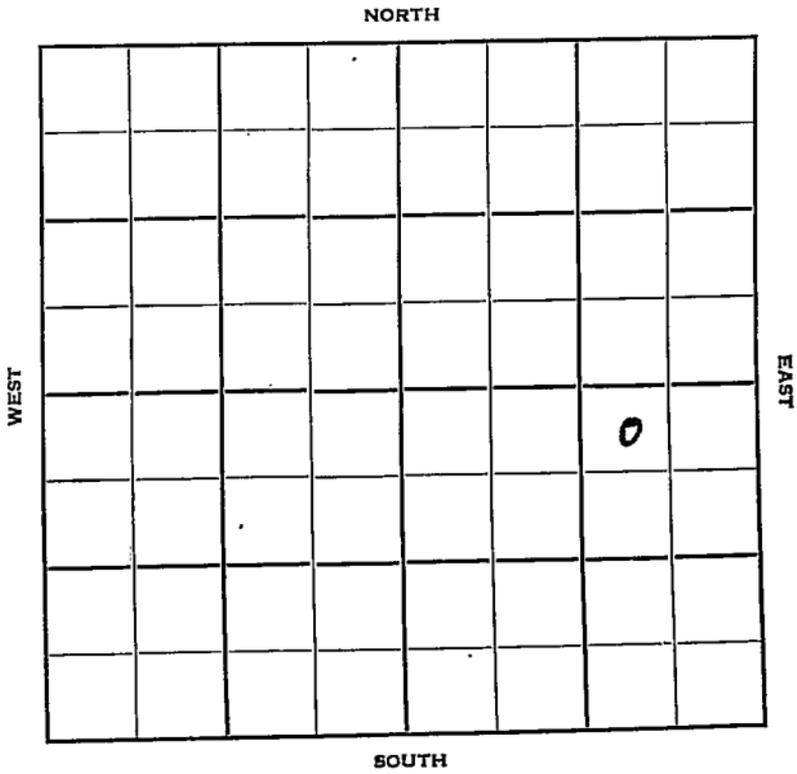



Sec. 4 Twp. 18 R. 8W

Well No. #2 Kratzer Farm

Dozier Oil Company

Stagg Drlg.- Contr. Contractor


330' Ft. from N. Line

..... Ft. from S. Line

990' Ft. from E. Line

..... Ft. from W. Line

NW NE SE

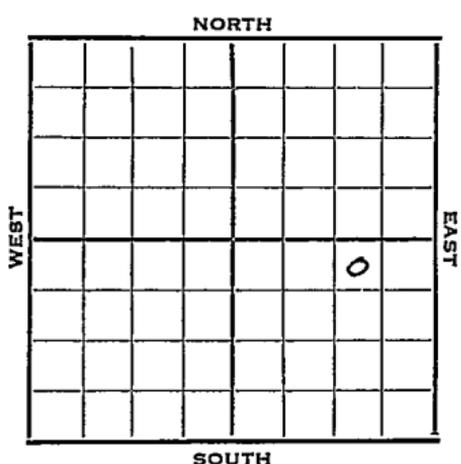

1952 Elev. 1768' REPORT

5/14 Spud 5-11-52
8" @ 205
Drlg. 1800'

5/21 Heeb 2720' Br li 2840' Lans. 2867'
Cong. 3229' Simp. 3270' Arb. 3305'
TD 3314' 5" @ 3306'

5/28 CO 3280' 68/ 3230-46 S/ 1 Boph
to shoot 30 qts. Nitro 3241-46

6/11 S/1 BOPH To shoot

6/18 Spud 5-11-52
Oil Well TD 3314
8" @ 205 Heeb. 2720
Br Lime 2840 Lans. 2867
Congl 3229 Simp 3270
Arb. 3305 TD 3314
5" @ 3306 CO to 3280
68/3230-46 S/1 boph 30 qt/3241-46
Compl 23 bopd

COMPLETED

