

Range ^{on}
(Kratzer)

WEST

EAST

NORTH

SOUTH

Rice

KANSAS

8W ✓

Sec. 4 Twp. 18 R.

Well No. #3 Krapzer Farm

Dozier Oil Company

Stagg Drlg. Contractor


Ft. from N. Line

330 Ft. from S. Line

990 Ft. from E. Line

Ft. from W. Line

SE $\frac{1}{4}$ SW SE SE

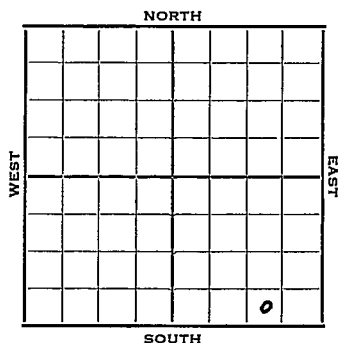

1952 Elev. 1764' REPORT

10/22 Spud 10-18-52

8" @ 214'

Anhy 385'

Drlg. 1650'

10/29 Heeb 2696' Br li 2821' Lans. 2845'
Cong. 3195' Simp. 3215' Arb. 3234'
RTD 3236' 5" @ 3234'

11/5 DD 3240 TD, S/10 BOPH 500A

11/12 NR

11/19 Spud 10-18-52 Oil well TD 3240'

8" @ 214' Anhy 385' Heeb 2696'

Br. line 2821' Lans. 2845' Cong.

3195' Simp. 3215' Arb. 3234'

TD 3236' 5" @ 3234' DD 3240'

S/10 BOPH 500 A

Comp. 3000 BOPD

COMPLETED

County Rice State Kansas

Sec. 4 (Blk.) 18 (Sur.) 87 Map No.

Operator Dazier Gil

Well No. 5 Farm Krapzer

Elev.	Location	SW	SE	SE
-------	----------	----	----	----

350 Ft. From S Line SE

000	Ft. From	Line	Quarter
-----	----------	------	---------

1st. Report OCT 22 1952

Completion

Remarks

Stagg Dwg. - Contr.

Spudding Date 10-18-52

Drlq. Data

8" @ 214 Anky 385 drlg. 1650


J. G. McGEHEE

County Rice State Kansas
 Sec. 4 (Blk.) 18 (Sur.) 8W Map No.

Operator Dozier Oil

Well No. 3 Farm Krapzer

Elev. 1764 Location SW SE SE

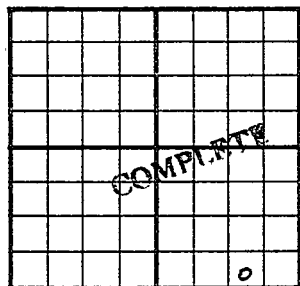

330 Ft. From S Line SE

990 Ft. From E Line Quarter

1st. Report

Completion NOV 19 1952

Remarks

Stagg D_rlg. - Contr.

Spudding Date 10-18-52

Drilg. Data Oil well TD 3240

8" @ 214 Anhy 385 Heeb. 2696

Br. lime 2821 Lans. 2845 Cong. 3195

Simp. 3215 Arb. 3234 TD 3236

5" @ 3234 DD 3240 S/ 10 boph 500 A

Comp. 3000 bopd