


Map No. K14 Sec. 33 Twp. 25 R. 5
Well No. 56 Trishout
Empire Company
Contractor

NORTH

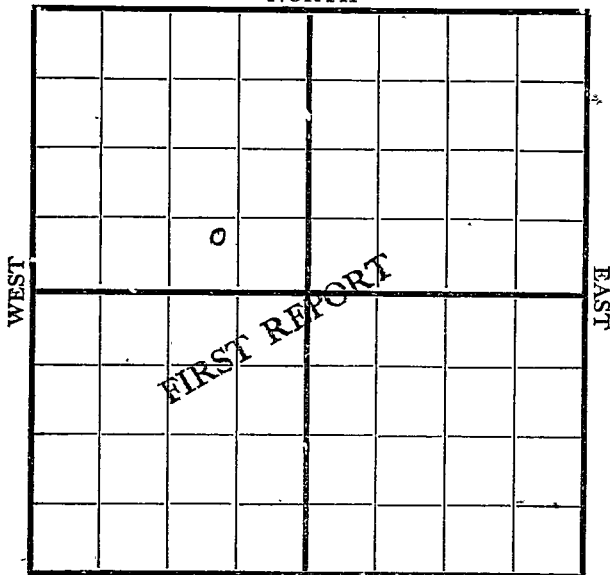

5855

SOUTH

735 E

Location

Rig up

Drilling and Remarks:

RECORD

Cased..... in., ft.

Sand.....

Gas.....

Oil.....

Total Depth.....

PRODUCTION

1st 24 hrs. Nat.

1st 24 hrs. after shot.....

Gas..... Cu. Ft.

Dry Hole.....

Abandoned.....

Date

3/27 1919

Trishout Scout

Map No. K 14 Sec. 33 Twp. 25 R. 5

Well No. 56 Pierpont


Empire Company

Contractor

NORTH

WEST

EAST

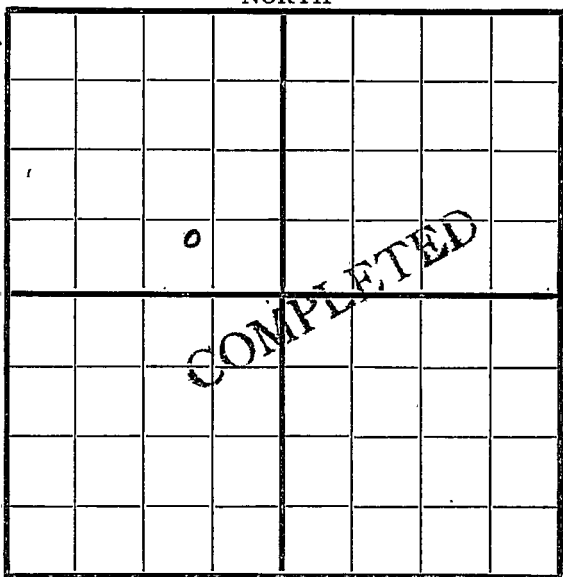

735 E

SOUTH

585 S

RECORD

Location _____

Cased _____ in., _____ ft.

Rig up _____

Sand 2407 - 2420

Drilling and Remarks:

Gas _____

Oil _____

100 bbls
18 hours

Total Depth _____

PRODUCTION

1st 24 hrs. Nat. _____

1st 24 hrs. after shot _____

Gas _____ Cu. Ft.

Dry Hole _____

Abandoned _____

Date

Pyle

6/27 1919

Scott