Form 51—5-19—5M—Mid-West

Map No._____ Sec. 33 Twp. 25 R. 5

Well No. 60 Pierpont Farm

Empire Company

NORTH

WEST

EAST

SOUTH

Location _____

Drilling Remarks:

Rig Up _____

Drilling Remarks:

RECORD

Cased _____ in. _____ ft.

Sand _____

Gas _____

Oil _____

Total Depth _____

PRODUCTION

1st 24 hrs. Nat. _____

1st 24 hrs. after shot _____

Gas _____ cu. ft.

Dry Hole _____

Abandoned _____

Form 26—1M Books of 100 Sheets Each—4-15-18

Map No. K14 Sec. 33 Twp. 25 R. 5

Well No. 60 Pierpont

Empire Company

Contractor

NORTH

WEST

EAST

SOUTH

990 S 330 E

FIRST REPORT

Location

Rig up

Drilling and Remarks:

Rig in up

RECORD

Cased in., ft.

Sand

Gas

Oil

Total Depth

PRODUCTION

1st 24 hrs. Nat.

1st 24 hrs. after shot

Gas Cu. Ft.

Dry Hole

Abandoned

Date 6/27 1919 Pyle Scout

Form 26—1M—4-19—Mid-West

Map No. K 14 Sec. 33 Twp. 25 R. 5

Well No. 60 Pierpont

Empire Company

Contractor

SECTION PLAT

Ft. from N. Line

990 Ft. from S. Line

330 Ft. from E. Line

Ft. from W. Line

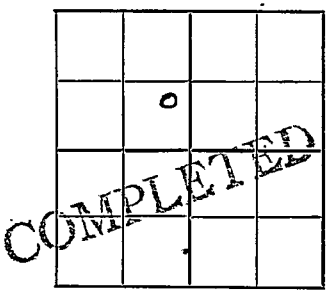

Location

Rig up

Drilling and Remarks:

RECORD

Cased in., ft.

Sand 1938-1954

Gas

Oil

Total Depth

PRODUCTION

1st 24 hrs. Nat. 77 bbls

1st 24 hrs. after shot

Gas Cu. Ft.

Dry Hole

Abandoned

Date 9/19 1919

Pyle Scout