


Map No. \_\_\_\_\_ Sec. 33 Twp. 25 R. 5

Well No. 61 Perpont Farm \_\_\_\_\_  
Empire Company

NORTH

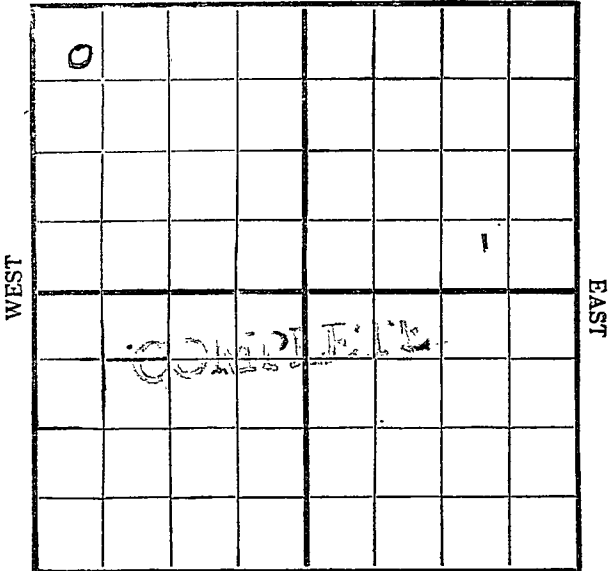

SOUTH

Location \_\_\_\_\_

Rig Up \_\_\_\_\_

Drilling Remarks: \_\_\_\_\_  
\_\_\_\_\_  
\_\_\_\_\_  
Drilling Remarks: \_\_\_\_\_  
\_\_\_\_\_  
\_\_\_\_\_  
RECORD

PRODUCTION

Cased \_\_\_\_\_ in. \_\_\_\_\_ ft.

1st 24 hrs. Nat. \_\_\_\_\_

Sand \_\_\_\_\_

1st 24 hrs. after shot \_\_\_\_\_

Gas \_\_\_\_\_

Gas \_\_\_\_\_ cu. ft.

Oil \_\_\_\_\_

Dry Hole \_\_\_\_\_

Total Depth \_\_\_\_\_

Abandoned \_\_\_\_\_




Map No. 1514 Sec. 33 Twp. 25 R. 5

Well No. 61 Fairmont

Empire Company

Contractor

NORTH

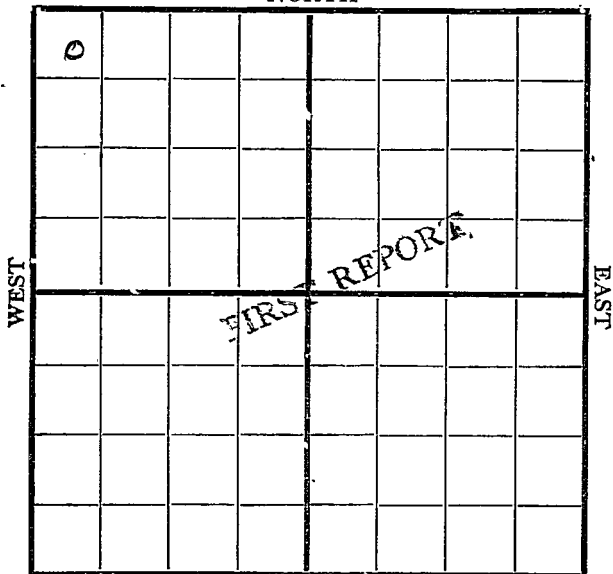

330 W

SOUTH

380 N

Location \_\_\_\_\_

Rig up \_\_\_\_\_

Drilling and Remarks:

Timber

RECORD

Cased \_\_\_\_\_ in., \_\_\_\_\_ ft.

Sand \_\_\_\_\_

Gas \_\_\_\_\_

Oil \_\_\_\_\_

Total Depth \_\_\_\_\_

PRODUCTION

1st 24 hrs. Nat. \_\_\_\_\_

1st 24 hrs. after shot \_\_\_\_\_

Gas \_\_\_\_\_ Cu. Ft.

Dry Hole \_\_\_\_\_

Abandoned \_\_\_\_\_

Date

7/9 1919 Cyle Scout

Map No. K14 Sec. 33 Twp. 25 R. 5

Well No. 61 Fairport

Empire Company

Contractor

SECTION PLAT

330 Ft. from N. Line

----- Ft. from S. Line

----- Ft. from E. Line

330 Ft. from W. Line

0			

COMPLETED

Location -----

Rig up -----

Drilling and Remarks:

RECORD

Cased ----- in., ----- ft.

Sand 2399 - 2415

Gas -----

Oil -----

Total Depth -----

PRODUCTION

1st 24 hrs. Nat. 50 bbls

1st 24 hrs. after shot -----

Gas ----- Cu. Ft.

Dry Hole -----

Abandoned -----

Date

10/27 1919

Pyle

Scout