


Section 33 Township 25 Range 5E

Well No. #88 Pierpont

Company Cities Service Oil

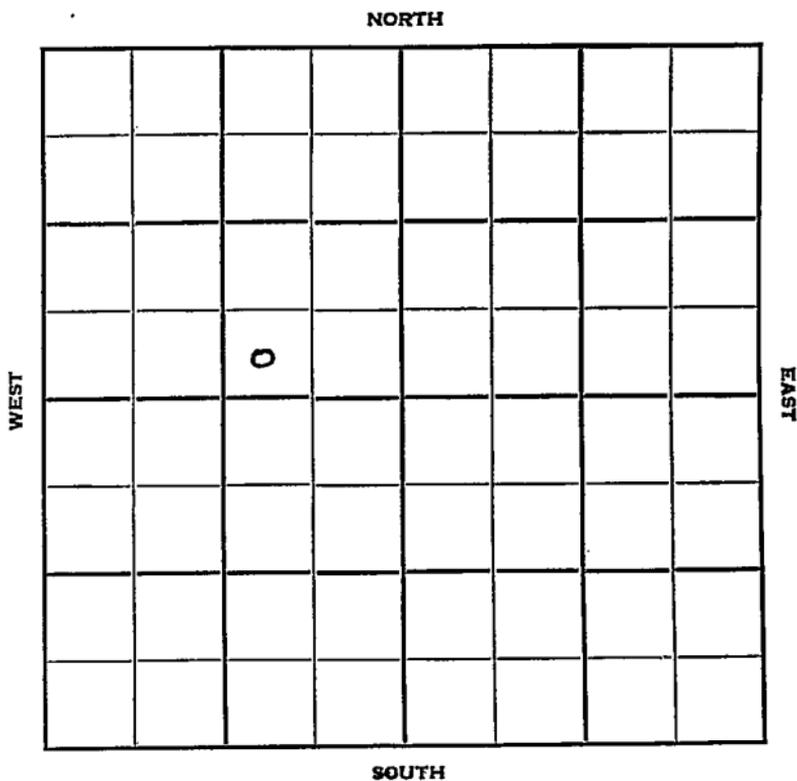

Sec. 33 Twp. 25 R. 5 E

Well No. # 88 Pierpont Farm _____

Cities Service Oil Company _____

Contractor _____


_____ Ft. from N. Line

200 Ft. from S. Line

1040 Ft. from E. Line

_____ Ft. from W. Line

SW SE NW

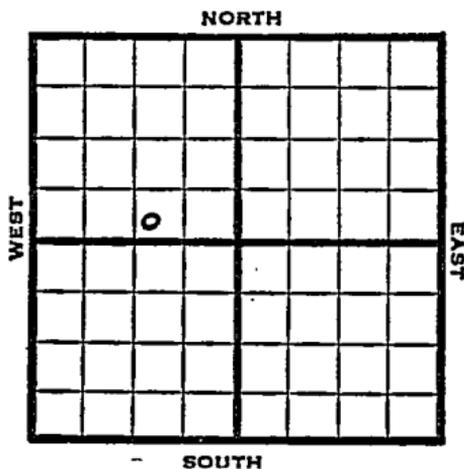

1952

Elev. 1363' REPORT

1/9

8" @ 86'
Drlg. 125'

1/30

Oil Well TD 642
8" @ 86
Sand 610
4 1/2" @ 608 TD 642
18/618-36 FU 200' oil 18 hr.
Comp. 14 bopd

COMPLETED

County **Butler** State **Kansas**

Sec. **33** (Blk. Twp.) **25** (Sur. Rge.) **5E** Map No.

Operator **Cities Service Oil**

Well No. **88** Farm **Pierpont**

Elev. Location **SW SE NW**

200 Ft. From **S** Line **NW**

1040 Ft. From **E** Line **Quarter**

Ist. Report **JAN 9 1952**

Completion

Remarks

Spudding Date

FIRST REPORT

Drlg. Data

8" @ 86 Drlg. 125

J. E. TYRA

