FORM 51


Butler

KANSAS

Section 33 Township 25 Range 5 E

Well No. # 91 Pierpont

Company Cities Service

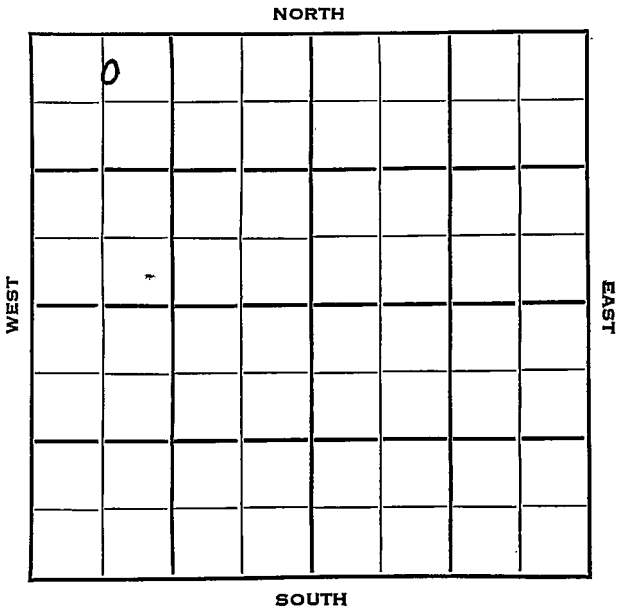

FORM 252-B
10M 10-50 PETROL

Butler KANSAS ✓

Sec. 33 Twp. 25 R. 5E

Well No. #91 Pierpont Farm

Cities Servide Company

Contractor

El Dorado Pool


330 Ft. from N. Line

Ft. from S. Line

Ft. from E. Line

770 Ft. from W. Line

NE NW NW

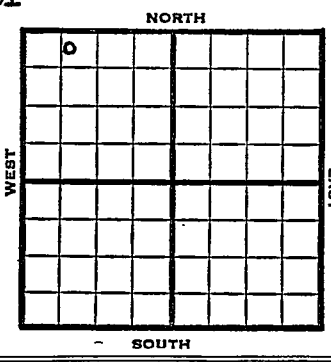


| 1953 | Elev. 1381' REPORT |
|---|---|
| 4/29 | Oil Well<br>TD 2435<br>10" @ 90<br>Doug 1490, Br lime 1576, KC 1660,<br>Arb. 2406<br>7" @ 2404<br>DD 2424, 500A, 1¼ boph<br>DD 2435, FU 800' oil 16 hrs., 1000A<br>Comp. 175 bopd 186 bw<br><br>FIRST REPORT<br>✓<br>COMPLETED |

FORM 275 FOR SALE BY KANSAS BLUE PRINT CO.


County Butler State Kansas

Sec. 33 (Blk. Twp.) 25 (Sur. Rge.) 5E Map No.

Operator Cities Service

Well No. 91 Farm Pierpont

Elev. 1381 Location NE NW NW

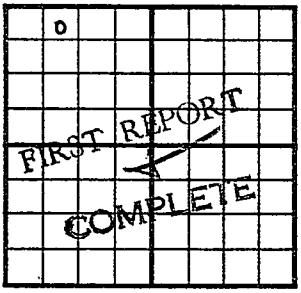


330 Ft. From N Line NW

770 Ft. From W Line Quarter

Ist. Report APR 2 9 1953

Completion APR 2 9 1953

Remarks ElDorado Pool

Spudding Date

Drlg. Data Oil well TD 2435

10" @ 90 Doug. 1490 Br. lime 1576

KC 1660 Arb. 2406 7" @ 2404 DD 2424

500 A 1½ boph DD 2435 FU 800' oil 16 hr

1000 A Comp. 175 bopd 186 bw

J. G. McGEHEE