


Section 33 Township 25 Range 5E

Well No. #1 S. Bierpoint (Pierpoint)

Company Cities Service Oil

NORTH

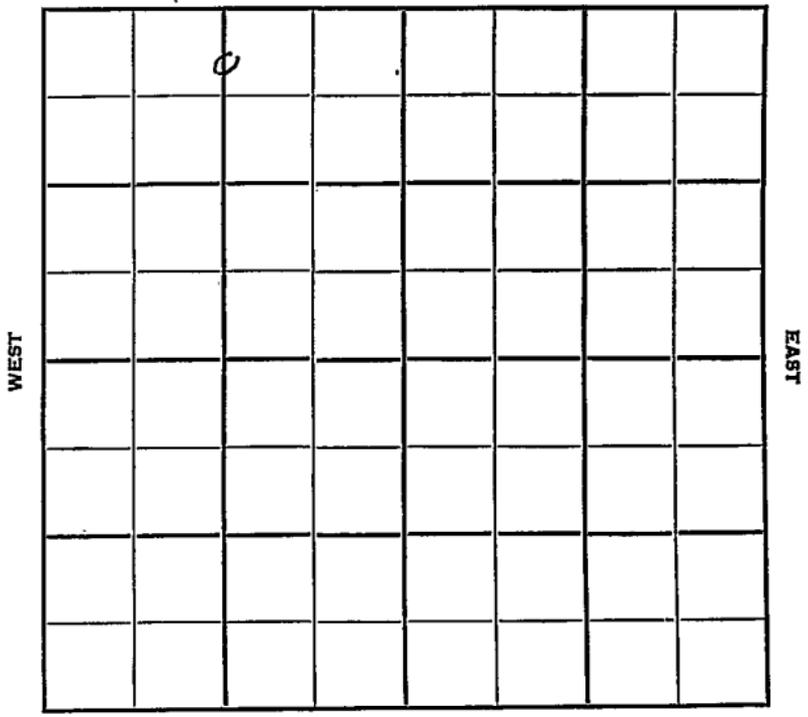

SOUTH

1
 2
 3
 4
 5
 6
 7
 8
 9
 10

Sec. 33 Twp. 25 R. 5E

Well No. #1 S. Bierpoint Farm

Cities Service Oil

Company

Contractor


400 Ft. from N. Line

Ft. from S. Line

Ft. from E. Line

1370 Ft. from W. Line

C N/2 N/2 NW

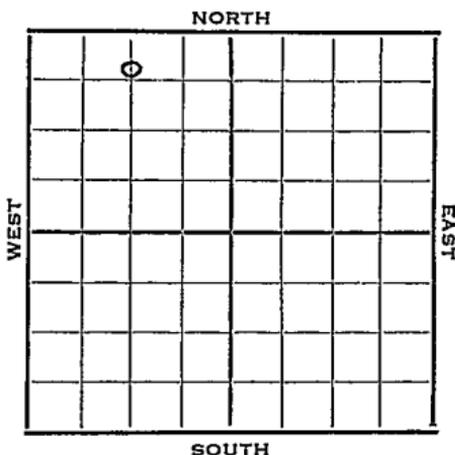

1952 Elev. 1385' RB REPORT

8/20 Lans. 1665 KC 1954
Arb. 2404 Granite 3076
TD 3096' wtr. supply

9/4 Wtr supply well TD 3096
Lans. 1665 KC 1954
Arb. 2404 Gr. 3076
TD 3096 Comp. for wtr supply well

ABANDONED

County Butler State Kansas

Sec. 33 (Blk.) 25 (Sur.) 5E Map No.

Operator Cities Service Oil

Well No. 1 Farm S. Bierpoint

Elev. 1385RB Location C N/2 N/2 NW

400 Ft. From N Line NW

1370 Ft. From W Line Quarter

1st. Report AUG 20 1952

Completion _____

Remarks _____

Spudding Date _____

Drlg. Data

Ians 1665 KC 1954 Arb 2404 Granite 3076

TD 3096 water supply

J. G. McGEHEE

County Butler State Kansas

Sec. 33 (Blk. 25 (Sur. 5E Map No.)
(Twp.) (Rge.)

Operator Cities Service

Well No. 1 Farm S. Bierpoint

Elev. 1385 Location C N L N $\frac{1}{2}$ NW

0					

400 Ft. From N Line NW

1370 Ft. From W Line Quarter

Ist. Report

Completion SEP 4 1952

Remarks

Spudding Date

Drlg. Data Water supply well TD 3096

Lans. 1665 KC 1954 Arb. 2404 Gr. 3076

TD 3096 Comp. for water supply well